


Piedmont Oil & Gas Co Inc.

BOOK 736 PAGE 410

AGREEMENT FOR THE USE OF TERRACE INC.

GREENVILLE S.C. 29601

5<sup>th</sup> Nov. 1963

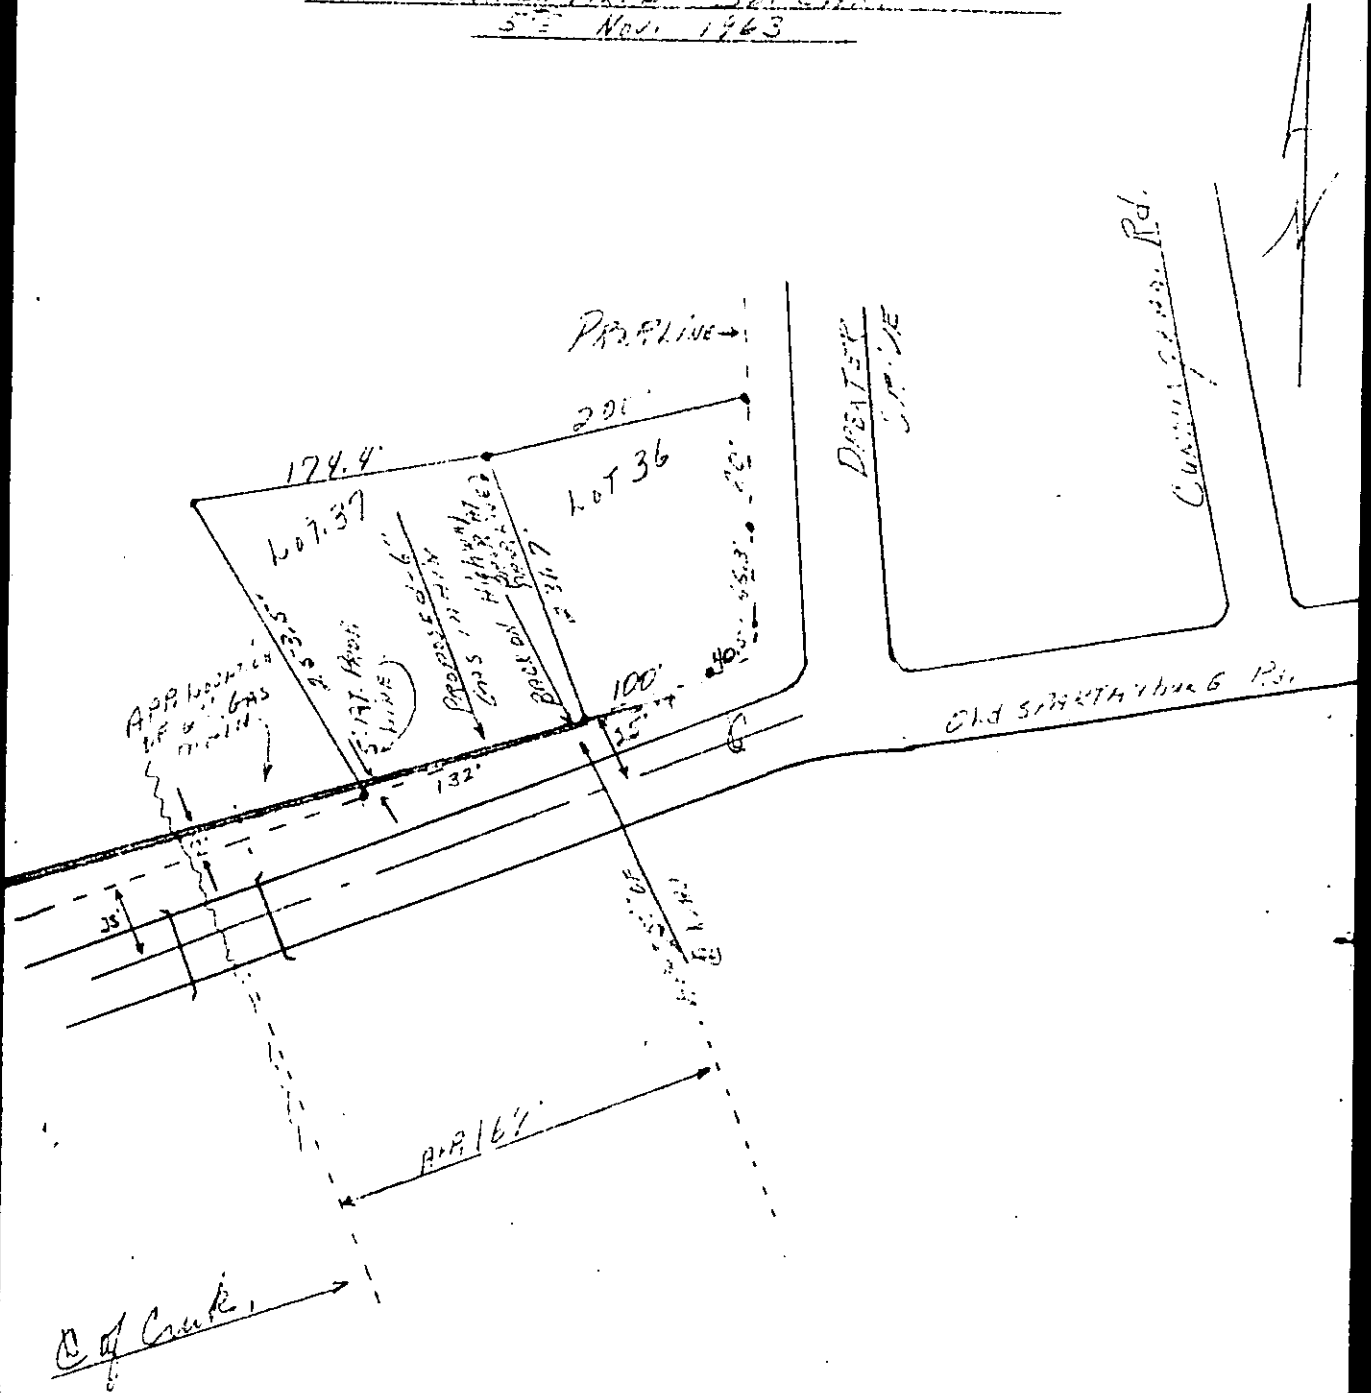

Recorded November 19, 1963 At 2:17 P.M. # 14862