



50,000 0-CM SOIL

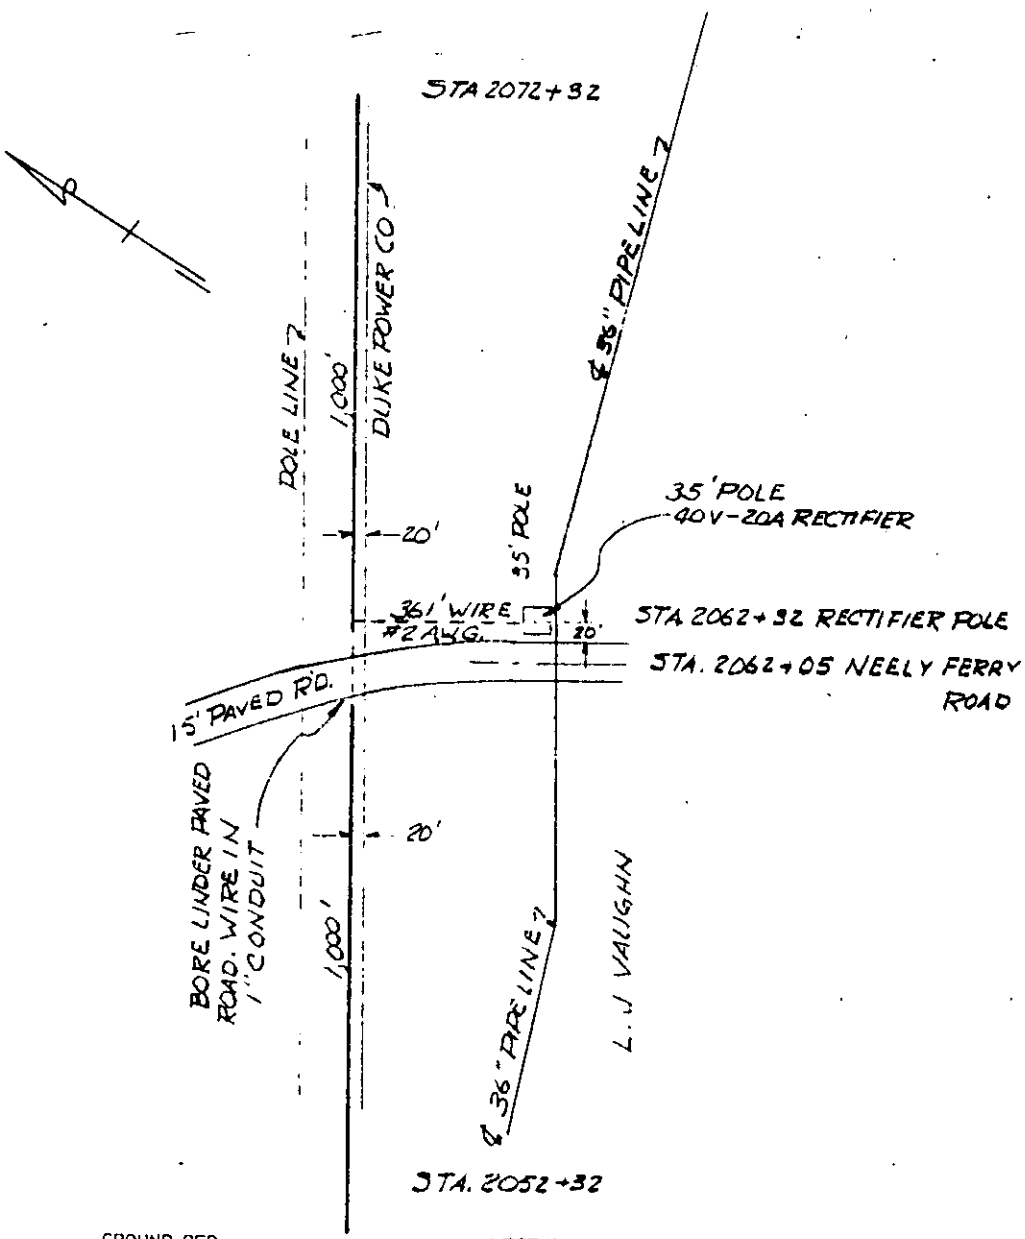

GROUND BED LEGEND RECTIFIER

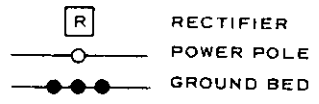

Alternate Site #2
 (ROSSON-RICHARDS - 9.4)

Recorded December 31, 1963 At 9:30 A.M. # 18651

DIV. CENTRAL MAP NO. 5.324.121 INSTALLED LINE HOUSTON-GREENSBORO 36" M.P. -2062+05 COUNTY GREENVILLE COUNTY STATE SC.	COLONIAL PIPELINE COMPANY ATLANTA, GEORGIA	DATE 9-10-63
	CATHODIC PROTECTION SITE C. P. UNIT NO. _____	SCALE 1" = 300' 1,304.95