
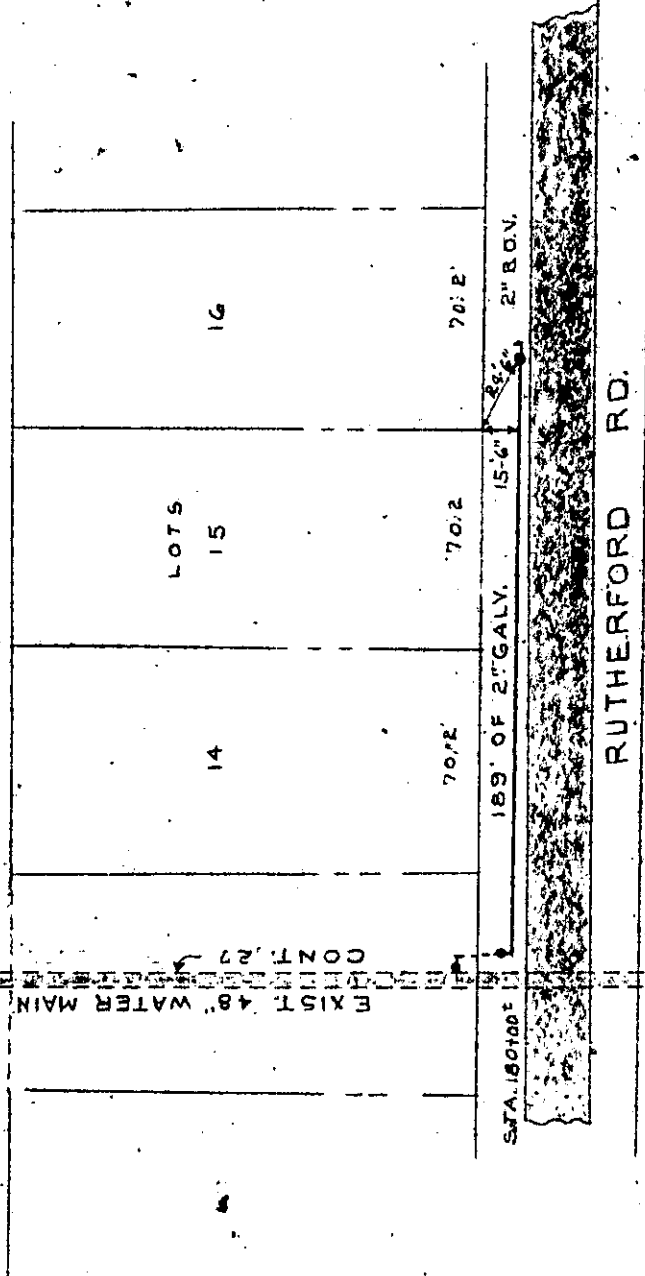


WILLIAM FRANKLIN CASE
TO
CITY OF GREENVILLE
189" OF 2" GALV PIPE

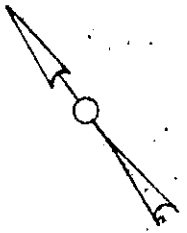

SCALE 1"=50
MB.

Recorded July 2, 1965 At 4:19 P.M. # 724