


Date July 27, 1965

Name of Applicant:
*Palmetto State Oil Co.
1902 N. Pleasantburg Dr.
Greenville S. C.*

County *Greenville*
Route
Road *White Oak Rd.*

The undersigned applicant hereby applies to the South Carolina State Highway Department for permit for encroachment on State Highway Right-of-Way as shown by sketch plan below.

SKETCH PLAN

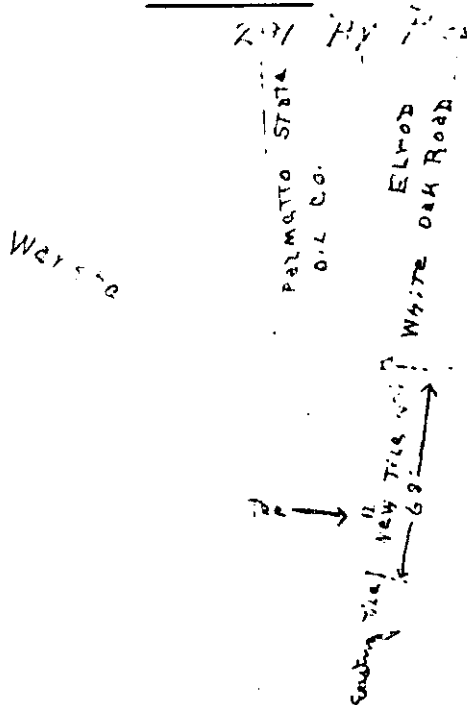

To install 68 ft. of drain tile as indicated above.

Palmetto State Oil Co.
By *S. A. [Signature]*

Date received by Res. Maint. Engr. or Maint. Supt.
Date forwarded by Res. Maint. Engr. or Maint. Supt.
Date received by Dist. Engr.
Date forwarded by Dist. Engr.

Signed: _____
Applicant Date
Recommended: _____
Dist. Engr. Date