


Scale 1" = 400'

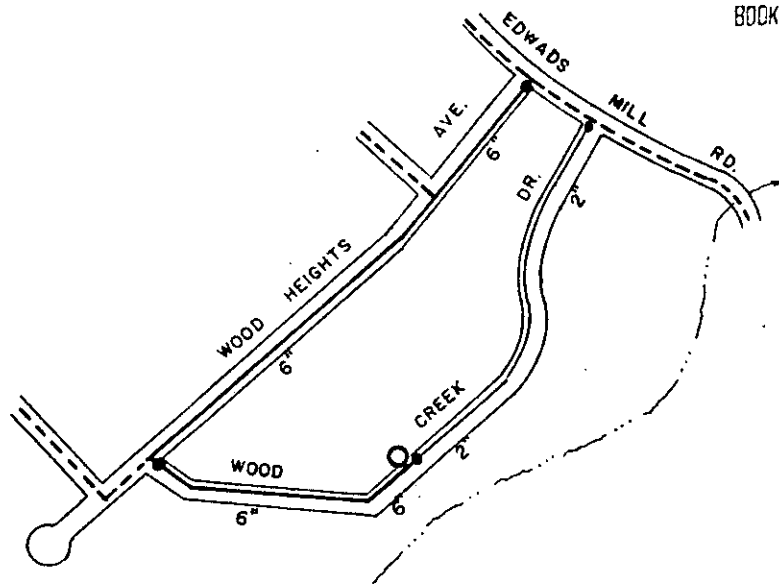

EDWARDS FOREST SECT. 3

Material List

- 2218'± of 6" C. I. Pipe
- 953' of 2" Galv. Pipe
- 1 - 8"x 6" Tapping Sleeve
- 1 - 6" Tapping ~~VALVE~~ VALVE
- 1 - Fire Hydrant
- 2 - 6" Valves
- 2 - 2" Valves

Mack A. Ashmore
To
City Of Greenville

Recorded April 11th., 1966 At 2:20 P.M. # 29170