


MATERIAL LIST:

- 3,471 ft. ± 6" C.I. Pipe
- 2,775 ft. ± 2" Galv. Pipe
- 3 - 6" Valves
- 3 - 2" Valves

BOOK 846 PAGE 182

Recorded May 31, 1968 At 4:52 P.M. # 31158

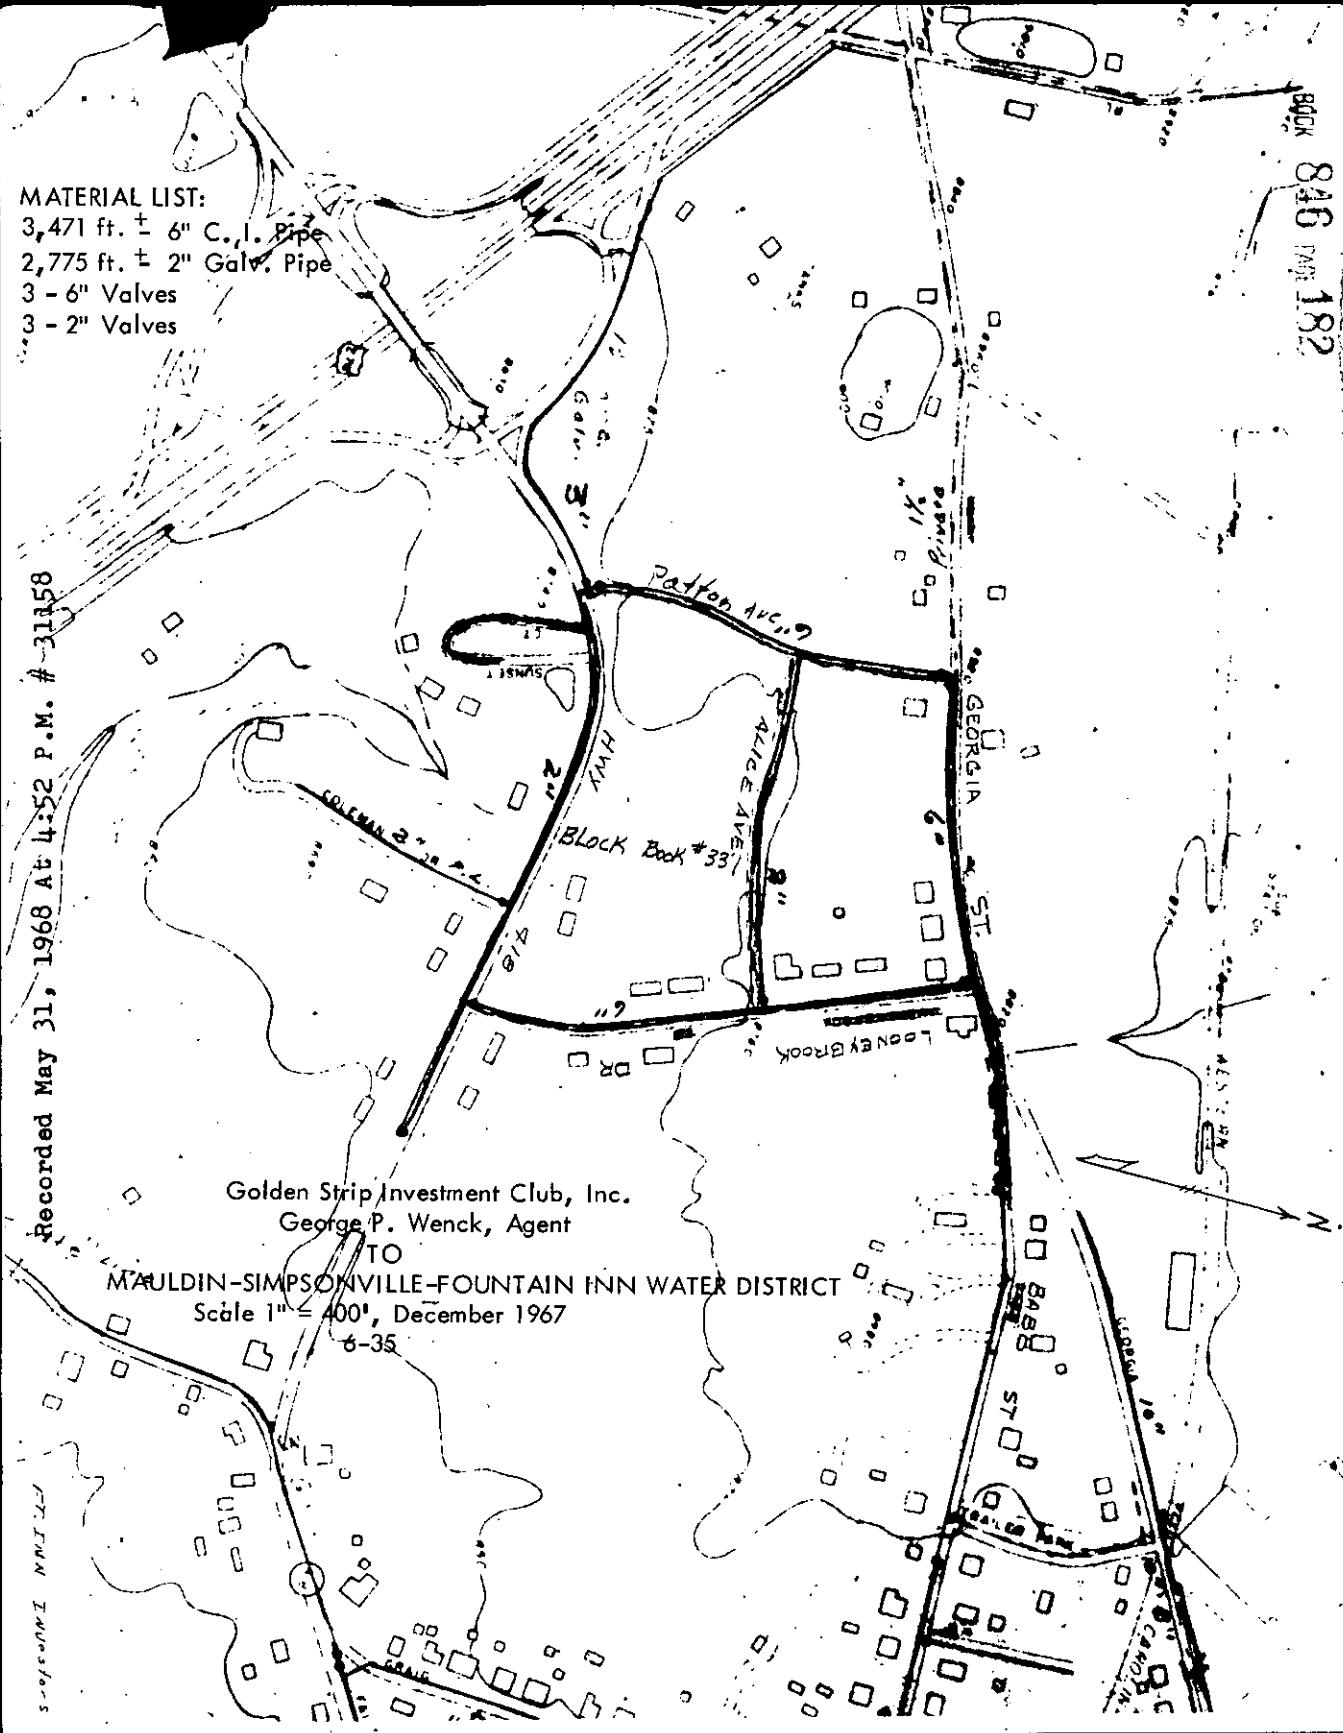

Golden Strip Investment Club, Inc.
George P. Wenck, Agent

TO MAULDIN-SIMPSONVILLE-FOUNTAIN INN WATER DISTRICT

Scale 1" = 400', December 1967
6-35

