


OGDEN ACRES

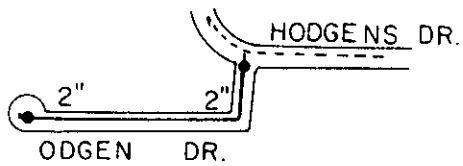

MATERIAL LIST

710' - 2" Pipe
2 - 2" Valves

J. Frank Williams
TC
Berea Public Service District
Scale 1" = 400' November 1967

Recorded May 31, 1968 At 5:02 P.M. # 31113

3-42