


DEC 2 - 1968 X+

BOOK 857 PAGE 233

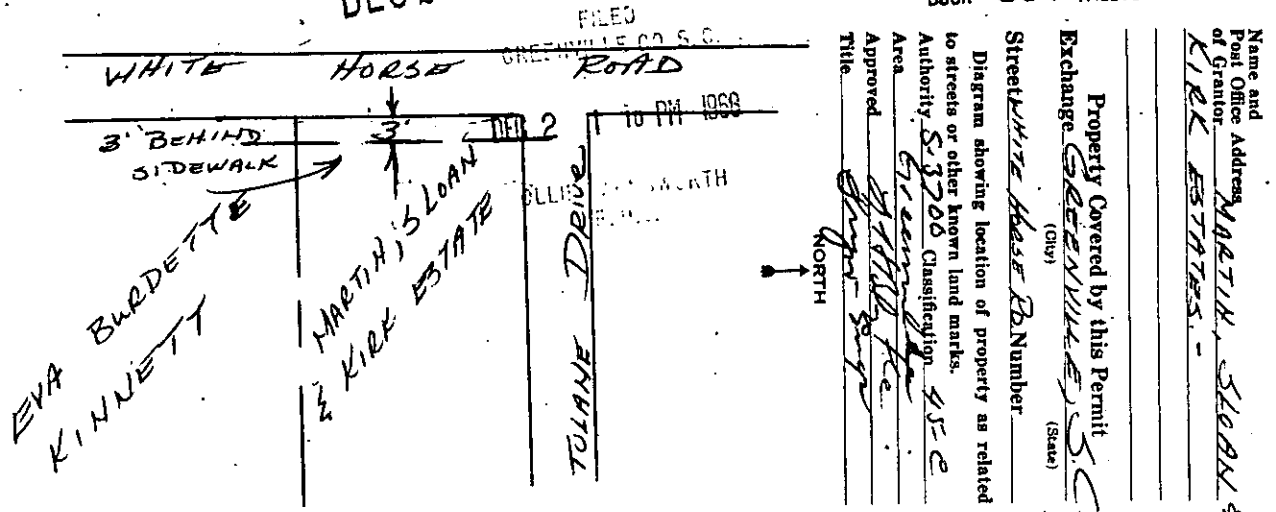

GEP 47.101

13262

EXCHANGE PLANT PERMIT

(INDIVIDUAL)

Form 8418 Mar. '68

Received of the SOUTHERN BELL TELEPHONE AND TELEGRAPH COMPANY ONE AND NO/100 Dollars, in consideration of which (I) (We) hereby grant said Company, its associated and allied companies, their respective successors and assigns, the right, privilege and authority to construct, operate and maintain its lines of telephone and telegraph, and for the general transmission of intelligence and/or for the purpose of the transmission and distribution of electric power, consisting of:

BURIED CABLE

and fixtures with the further right to permit the attachment of wires of any other Company, or persons, to said poles and fixtures UNDER the property which (I) (We) own, or have an interest, located in the City of GREENVILLE, County of GREENVILLE, and State of SOUTH CAROLINA, to-wit: THAT TRACT OF LAND BOUNDED ON THE SOUTH BY THE PROPERTY OF EVA BURDETTE KINNETT, ON THE NORTH BY THE PROPERTY OF TULANE DRIVE AND ON THE WEST BY WHITE HORSE ROAD.

Executed November 2, 1968  
(Post Office Address)

Witness:

Joel F. Burgess  
Mrs. Jack Porter

[Signature] (L. S.)  
[Signature] (L. S.)  
[Signature] (L. S.)

A. C. HODGENS

GEP 47.101

Form 8425 Nov. '64

ACKNOWLEDGMENTS

For Use in South Carolina

Individual Form

STATE OF SOUTH CAROLINA }  
COUNTY OF Greenville } ss.

Personally appeared before me JOEL F. BURGESS  
and made oath that (he) (~~she~~), with MRS. JACK PORTER saw the within named A. C. HODGENS

sign, seal, and deliver as (his) (her) (~~their~~) act and deed the within written instrument, and that (he) (~~she~~) with the said MRS. JACK PORTER witnessed the execution thereof.

Sworn to before me this 5 day of November A.D. 1968  
[Signature]  
Notary Public Expires 1-1-70

Joel F. Burgess  
Right of Way Recorded December 2, 1968 At 1:10 P.M. # 13262