


GLENWOOD ROAD

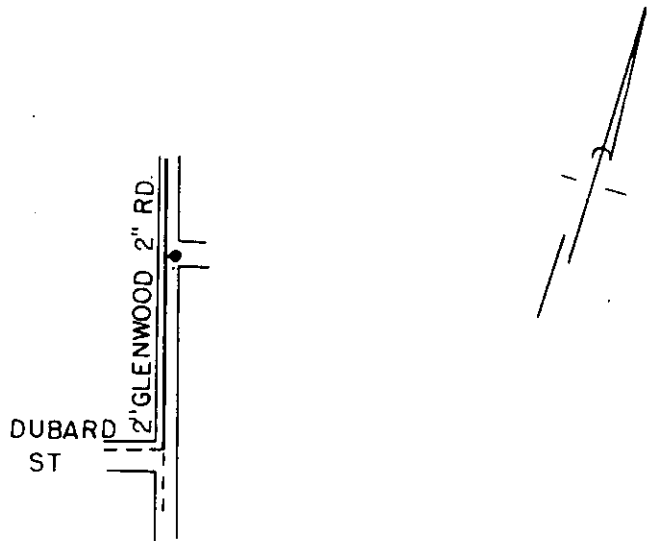

MATERIAL LIST

- 722'± - 2" Galv. Pipe
- 1 - 2" Valve

John T. Gilbert &
Louie Gilbert
To
Wade Hampton Water & Sewer District

Scale 1" = 400', June 1968

Recorded December 31, 1968 At 4:54 P.M. # 15639