



CUTTINO CIRCLE

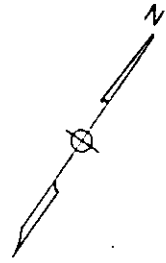

Plat 1209

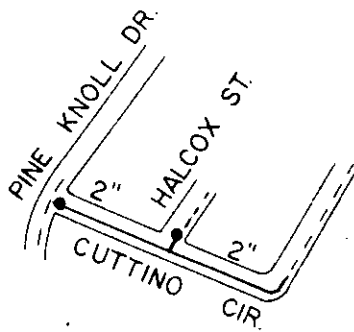

MATERIAL LIST

- 670'± - 2" Galv. Pipe
- 2 - 2" Valves

Inez B. Hall
To
Wade Hampton Water & Sewer District

Scale 1" = 400'
July 1968

Recorded December 31, 1968 At 4:53 P.M. # 15645