


MATERIAL LIST

- 3,180'± - 6" C.I. Pipe
- 6,680'± - 2" Galv. Pipe
- 4 - 6" Valves
- 14 - 2" Valves
- 0 - Fire Hydrants

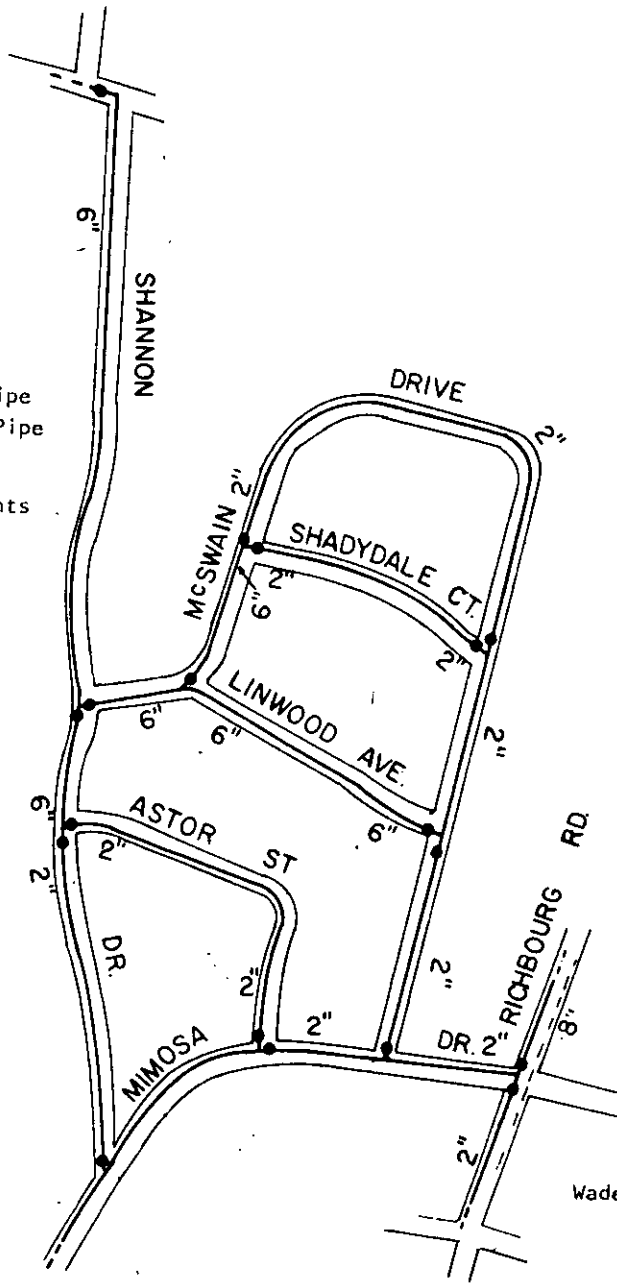

Wm. R. Timmons, Jr.
To
Wade Hampton Water & Sewer Dist.

Scale 1" = 400'
June 1968

Recorded December 31, 1968 At 4:55 P.M. # 15660