


Property of  
First Baptist Church  
Showing Proposed relocation  
of Greater Greenville Sewer District  
Sanitary Sewer Line  
May 26, 1969 By R.D. Williams - S.C.H.P.  
Scale 1"=20'

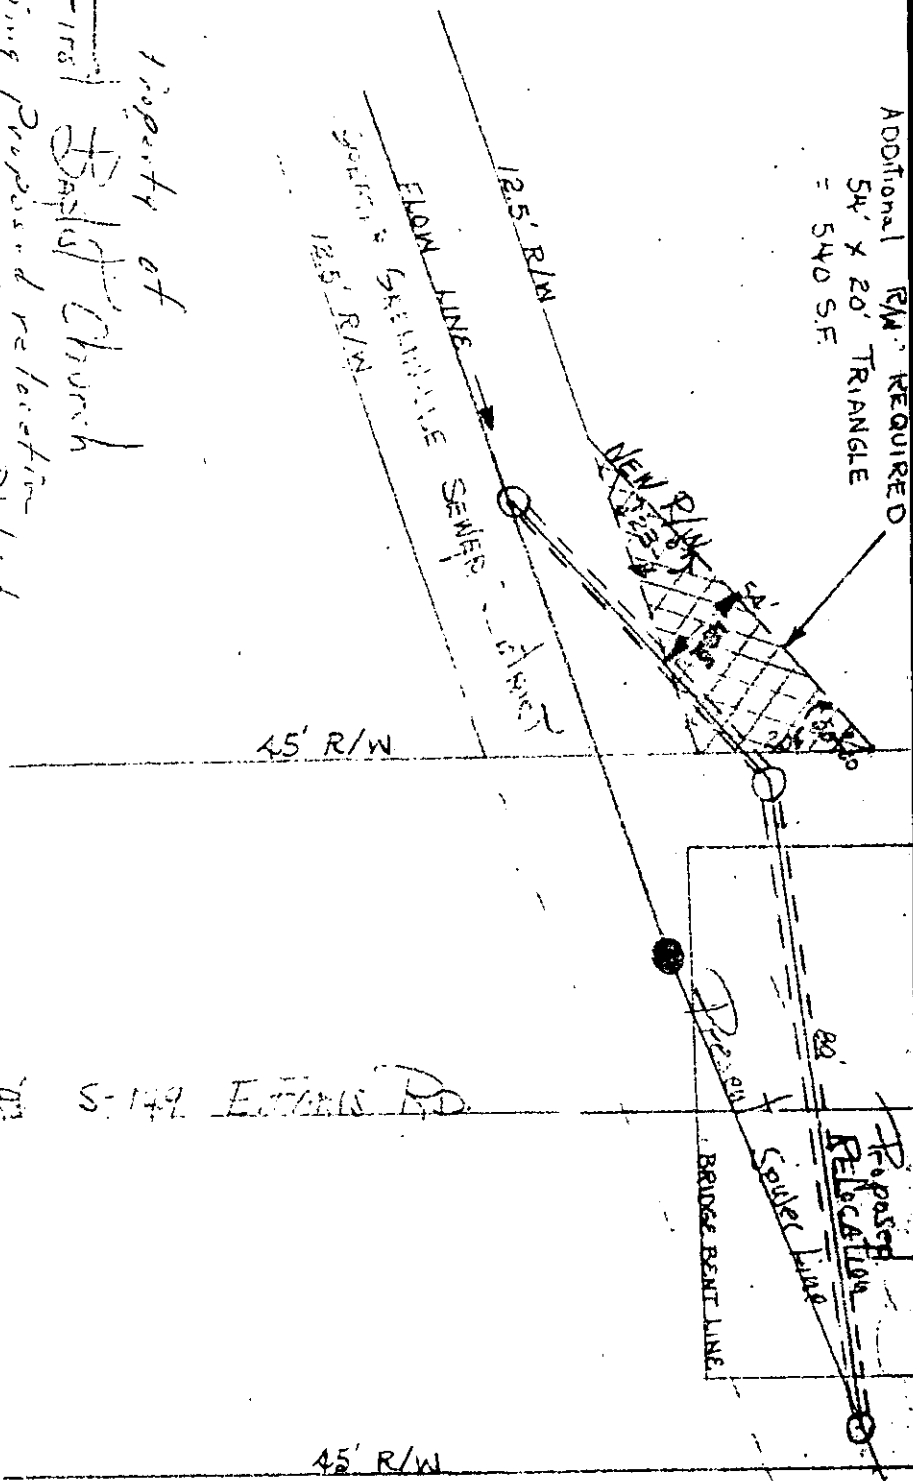

File 23,584 IN S-149 EDWARDS RD.