


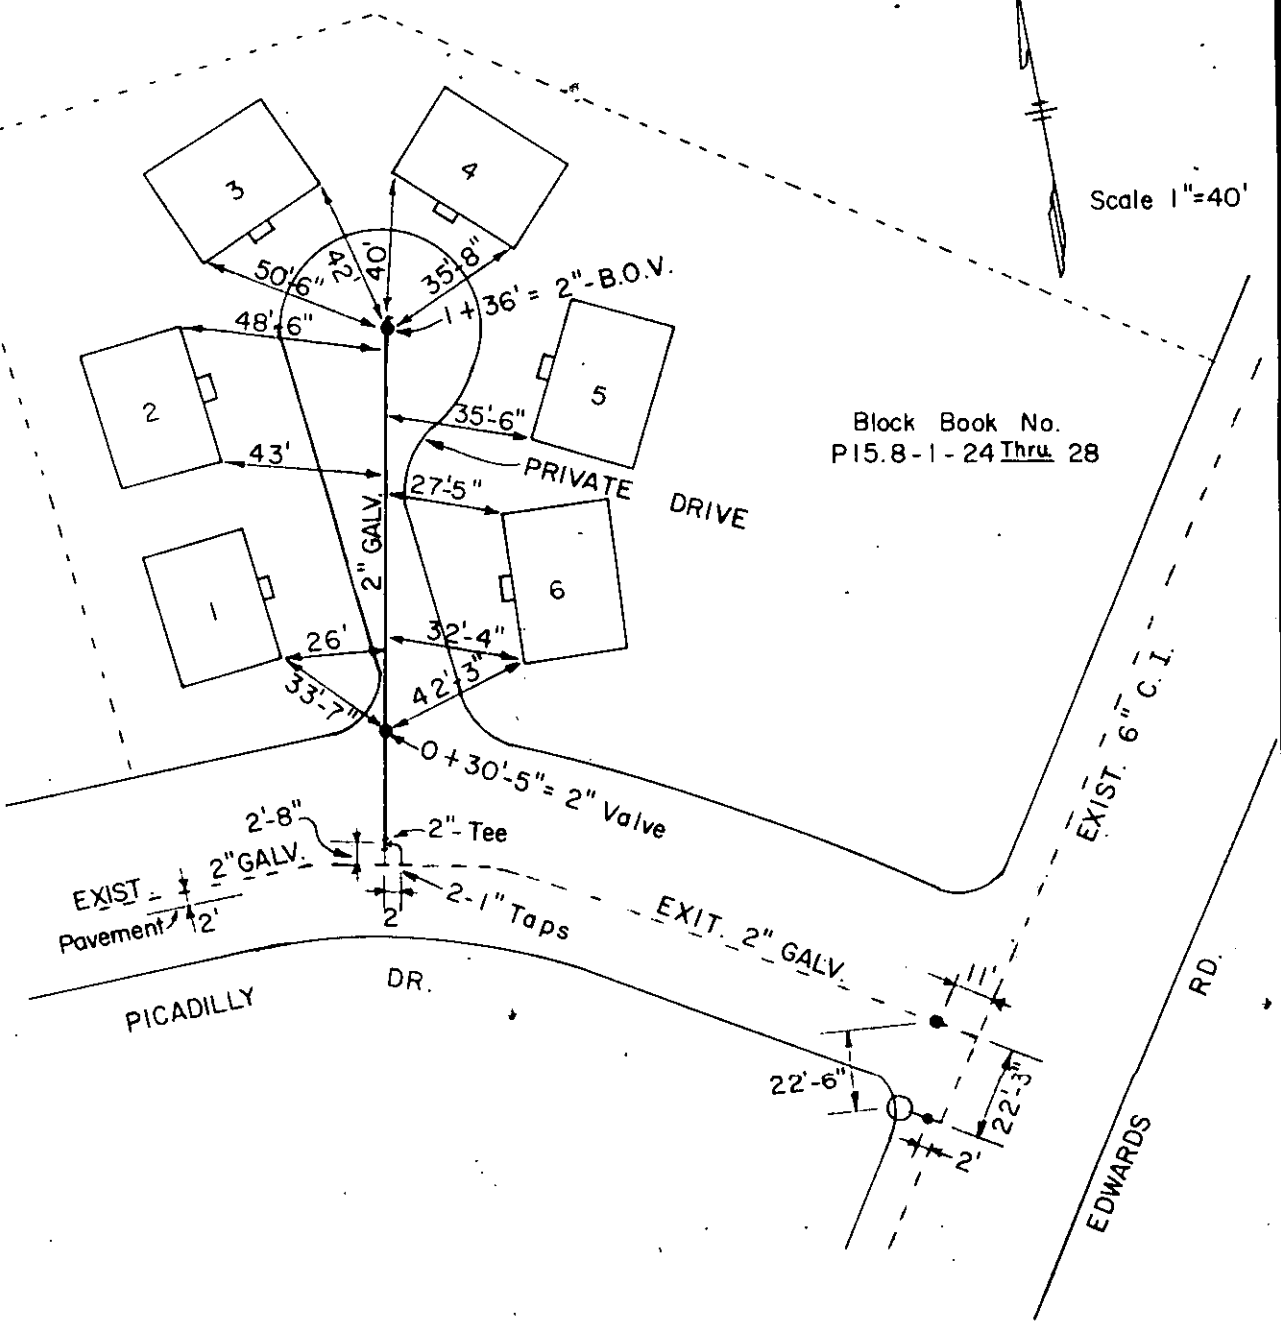

Scale 1"=40'



Block Book No.
P15.8-1-24 Thru 28

MATTOX & DILLARD
TO
CITY OF GREENVILLE
AUGUST, 1969

Recorded September 4, 1969 At 12:11 P.M. # 5539