


LONG FOREST DR.

NEW PERRY RD.

VCL 887 PAGE 300



SCALE 1"=400'

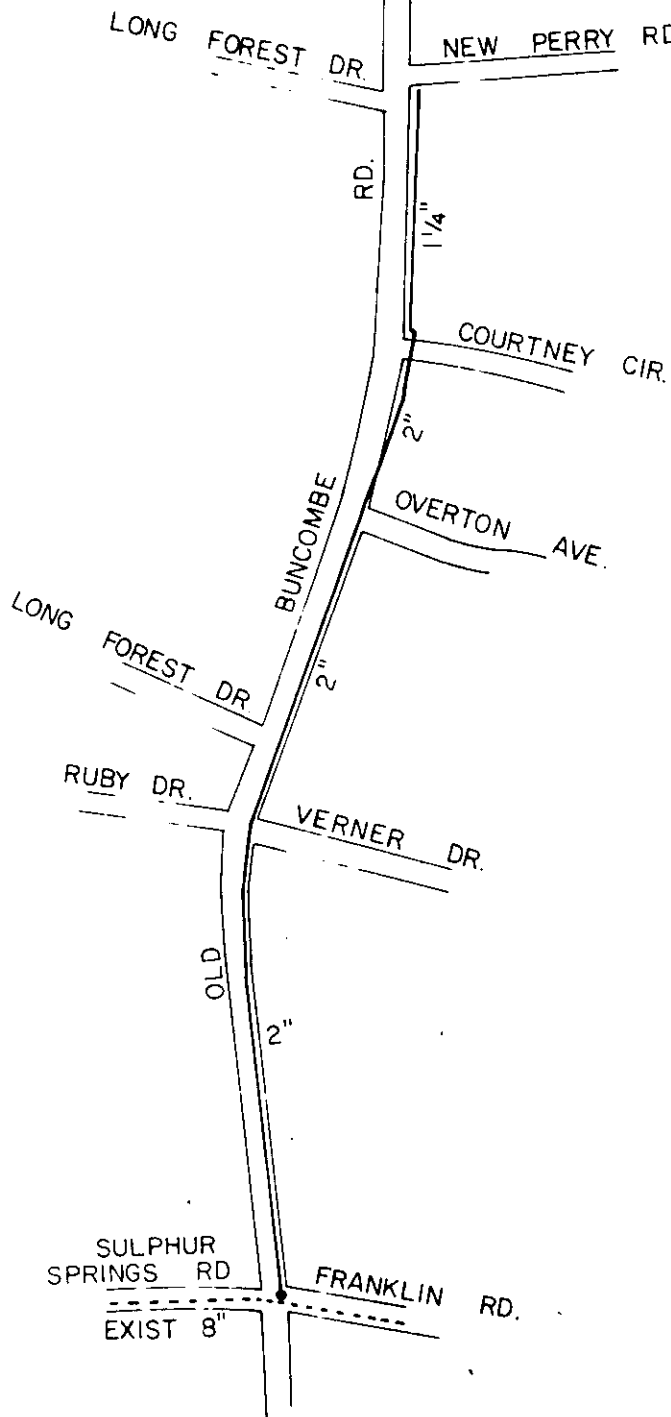

Material List

- 2530' = 2" valv. Pipe
- 600' = 1 1/4" valv. Pipe
- 1 = 2" valv

Mrs. R. K. Taylor, Jr.  
 to  
 City of Greenville  
 March, 1970

Recorded April 6th, 1970 at 3:13 P.M. #21792