


LEGEND

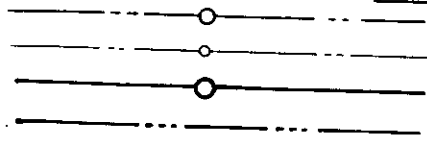

OLD PROPERTY LINE AND CORNER
 NEW PROPERTY LINE AND CORNER
 SEWER LINE AND MANHOLE
 12' EASEMENT LINE

FILED
 GREENVILLE CO. S. C.
 APR 3 2 34 PM '70
 OLLIE FARNSWORTH
 R.M.C.

SEWER LINE LOCATION

DRAWING TITLE

DRAWN: WASTERLAIN

CHECKED: McMAHAN

APPROVED: DAVIS

SCALE:
 1" = 40'

DATE:
 MAY 2, 1969