22095

APR 9 1970

FILED
GREENVILLE CO. S. C.
APR 9 2 35 PM '70
DOLLIE FARNSWORTH
R.M.C.

VOL 887 PAGE 496

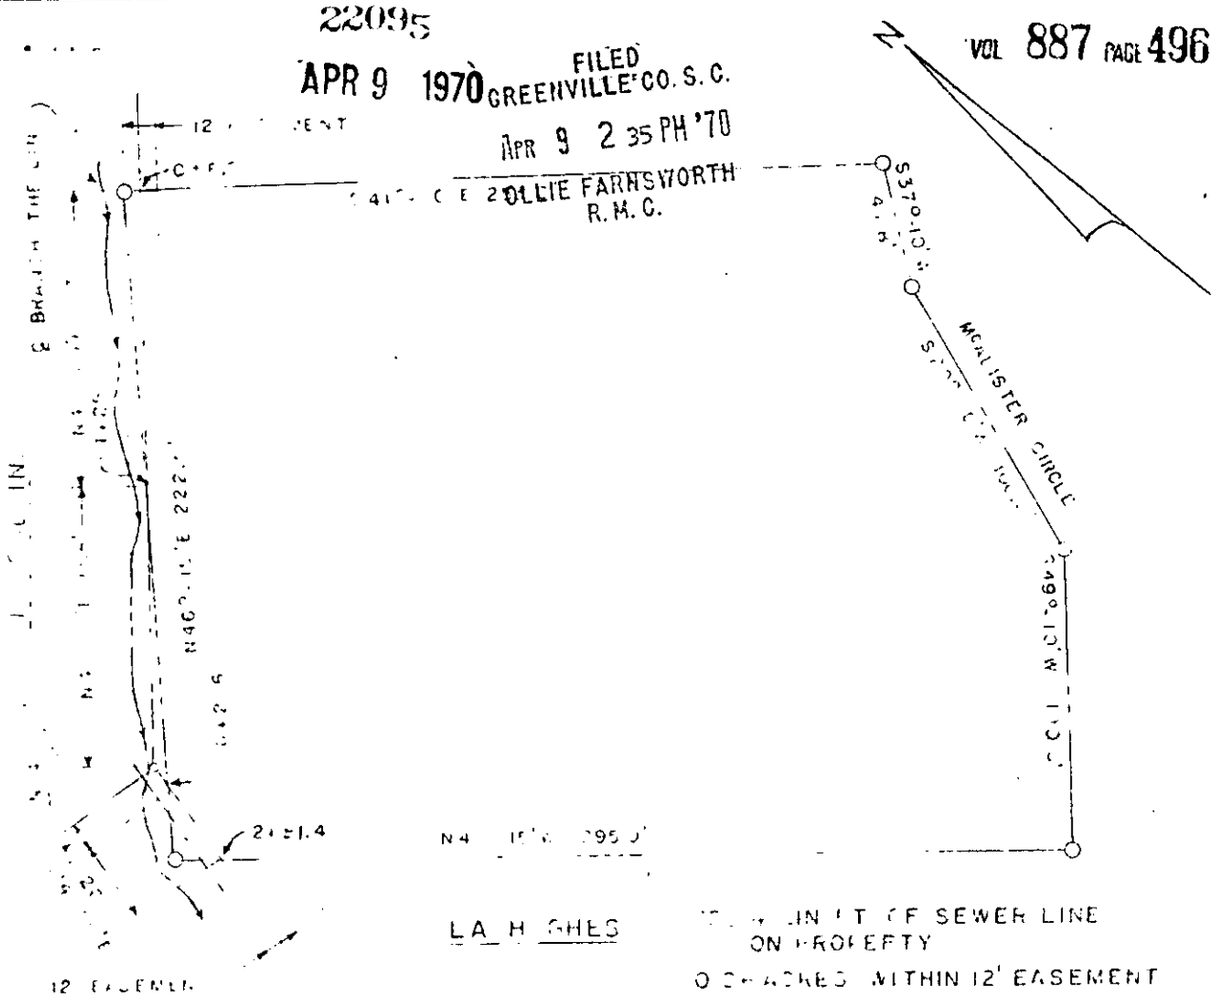

LEGEND

PROPERTY CORNER

I CERTIFY THE LOCATION OF SEWER LINE ON THE ABOVE PROPERTY TO BE CORRECT TO THE BEST OF MY KNOWLEDGE.

SC REG NO. 1874

LOCATION OF SEWER LINE ON PROPERTY

0.04 ACRES WITHIN 12' EASEMENT

PLAT

SHOWING

SEWER LINE LOCATION

ON THE PROPERTY OF

T. FRANK & MARTHA E. McALISTER

LOT 8 ECHO HILLS

LOCATED IN

GREENVILLE COUNTY, S.C.

SCALE 1"=50' MAY 1, 1969

DAVIS & FLOYD ENGINEERS, INC

GREENWOOD, S.C.

Recorded April 9th, 1970 at 2:35 P.M. #22095