


EAST LEE ROAD

EXIST. 6" C.I.

EXIST. 48" MAIN

SCALE 1"=100'

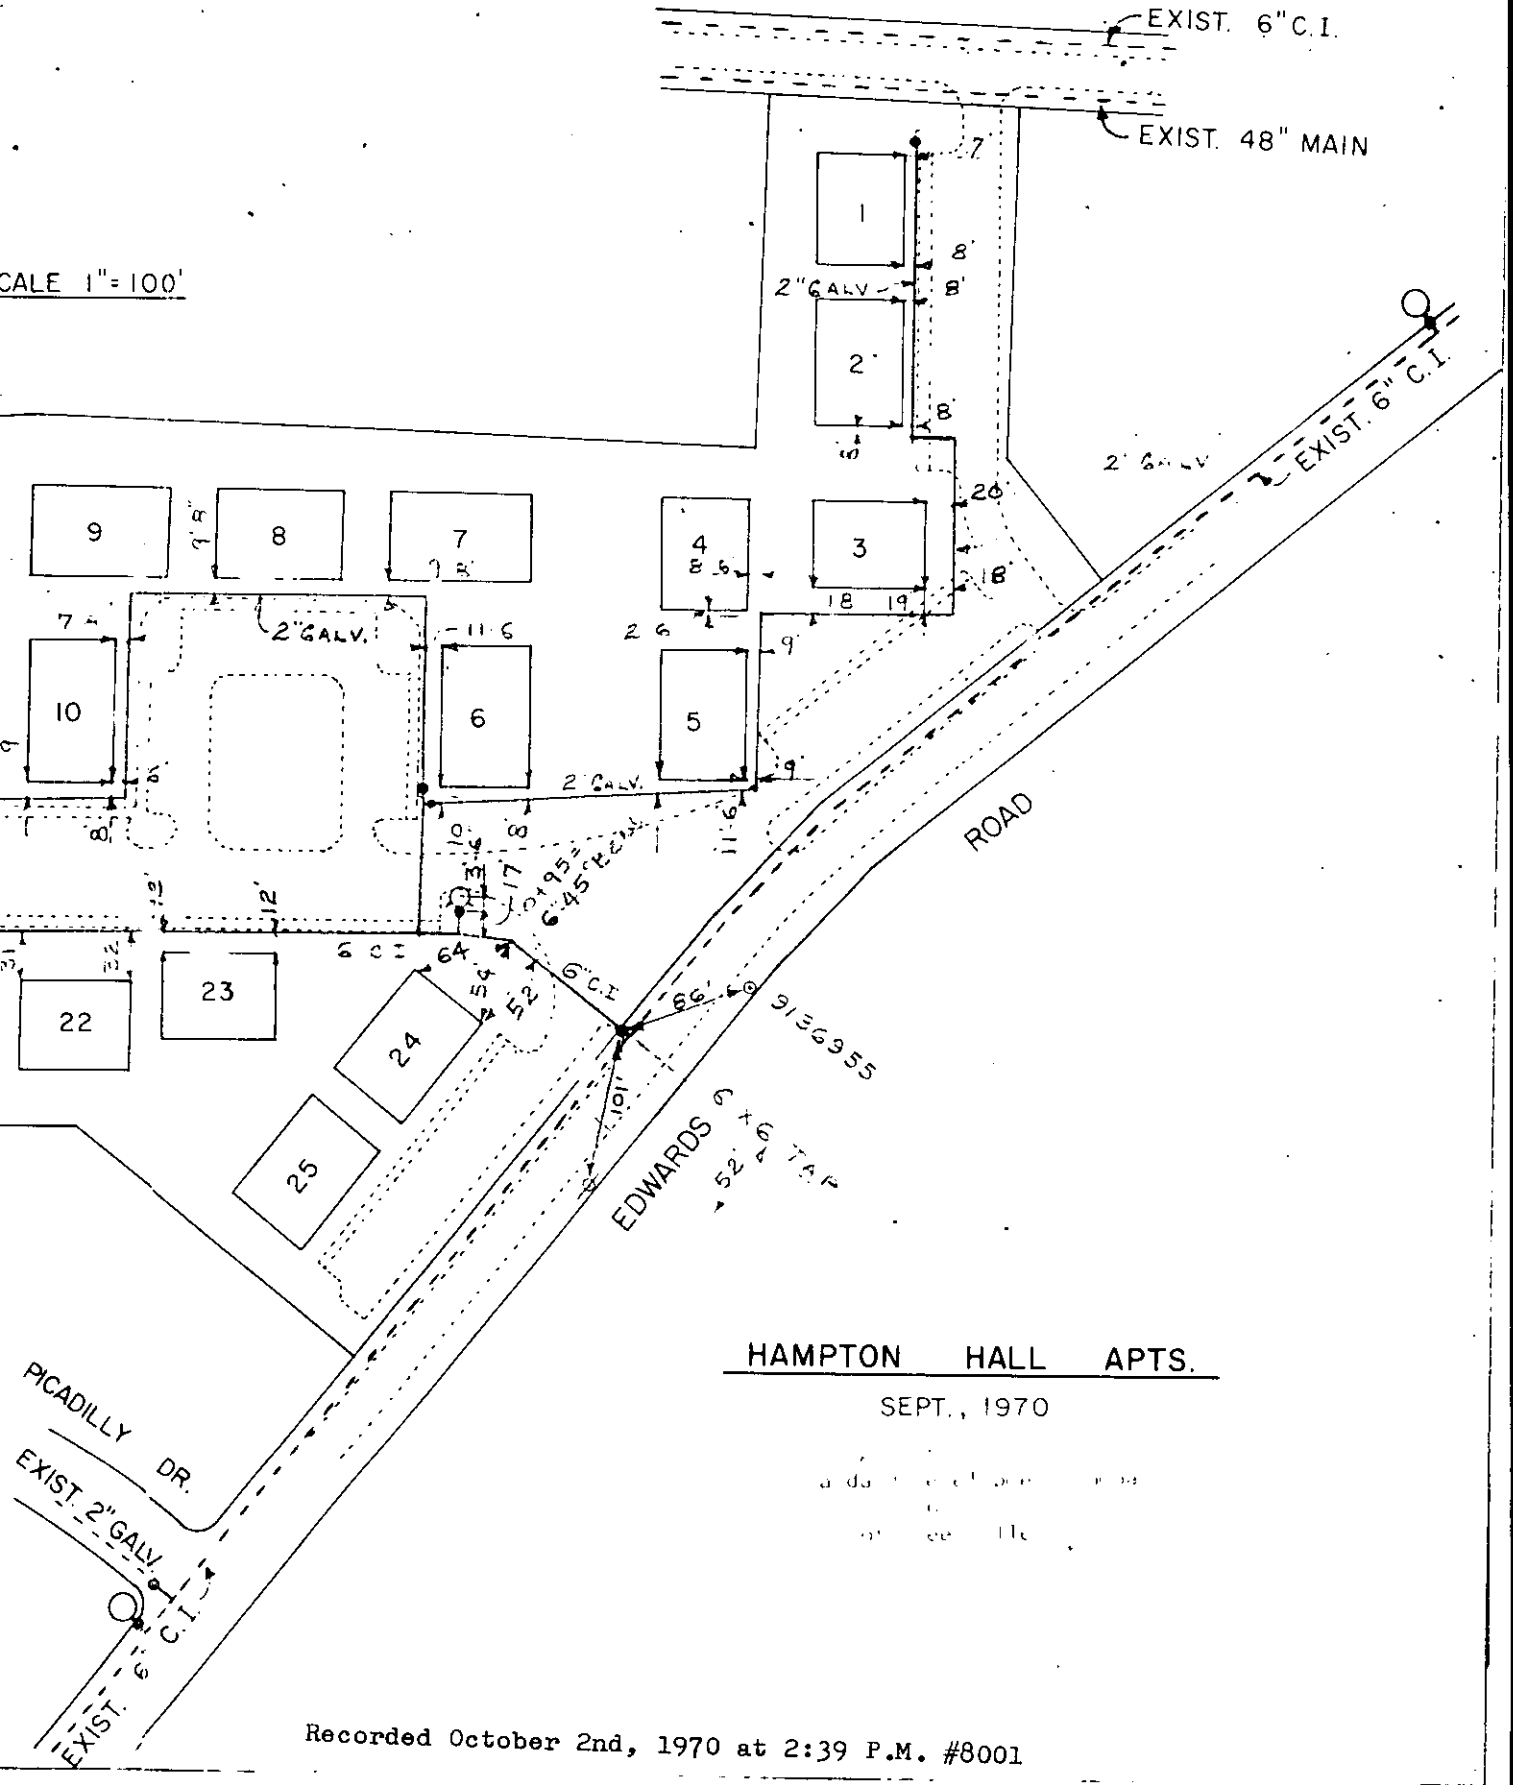

HAMPTON HALL APTS.

SEPT., 1970

and the other  
to  
see the

Recorded October 2nd, 1970 at 2:39 P.M. #8001