

12" X 6" MJ TAPPING
SLEEVE & G. M.J.
TAPPING VAL.

DR.

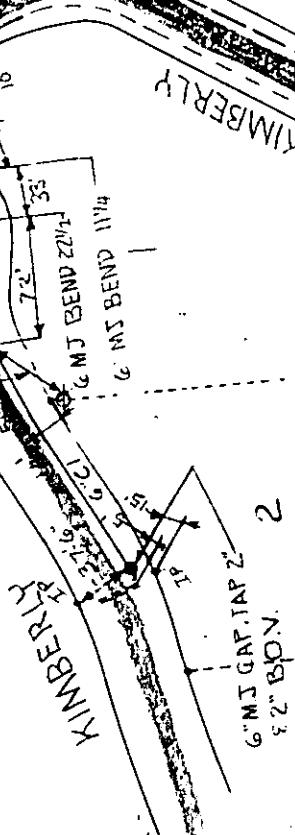
TO STATE PARK RD
EXS 12

6" MJ SOLID SLEEVE
6" MJ BEND 11¹/₄"

CT.

6" MJ BEND 11¹/₄"

KIMBERLY CT.
SCALE 1"=100'

Material List:

6"	Pipe	360'
6"	Valve	1
2"	Valve	1

Alva D. Rainey
to
City of Greenville
May 11, 1972

KIMBERLY CT.

APRIL, 1972
BL. BK. 498.1

