

17 x 10 + 10
17118 114






Drawn by:
Checked by:

Sheet:
17118 114

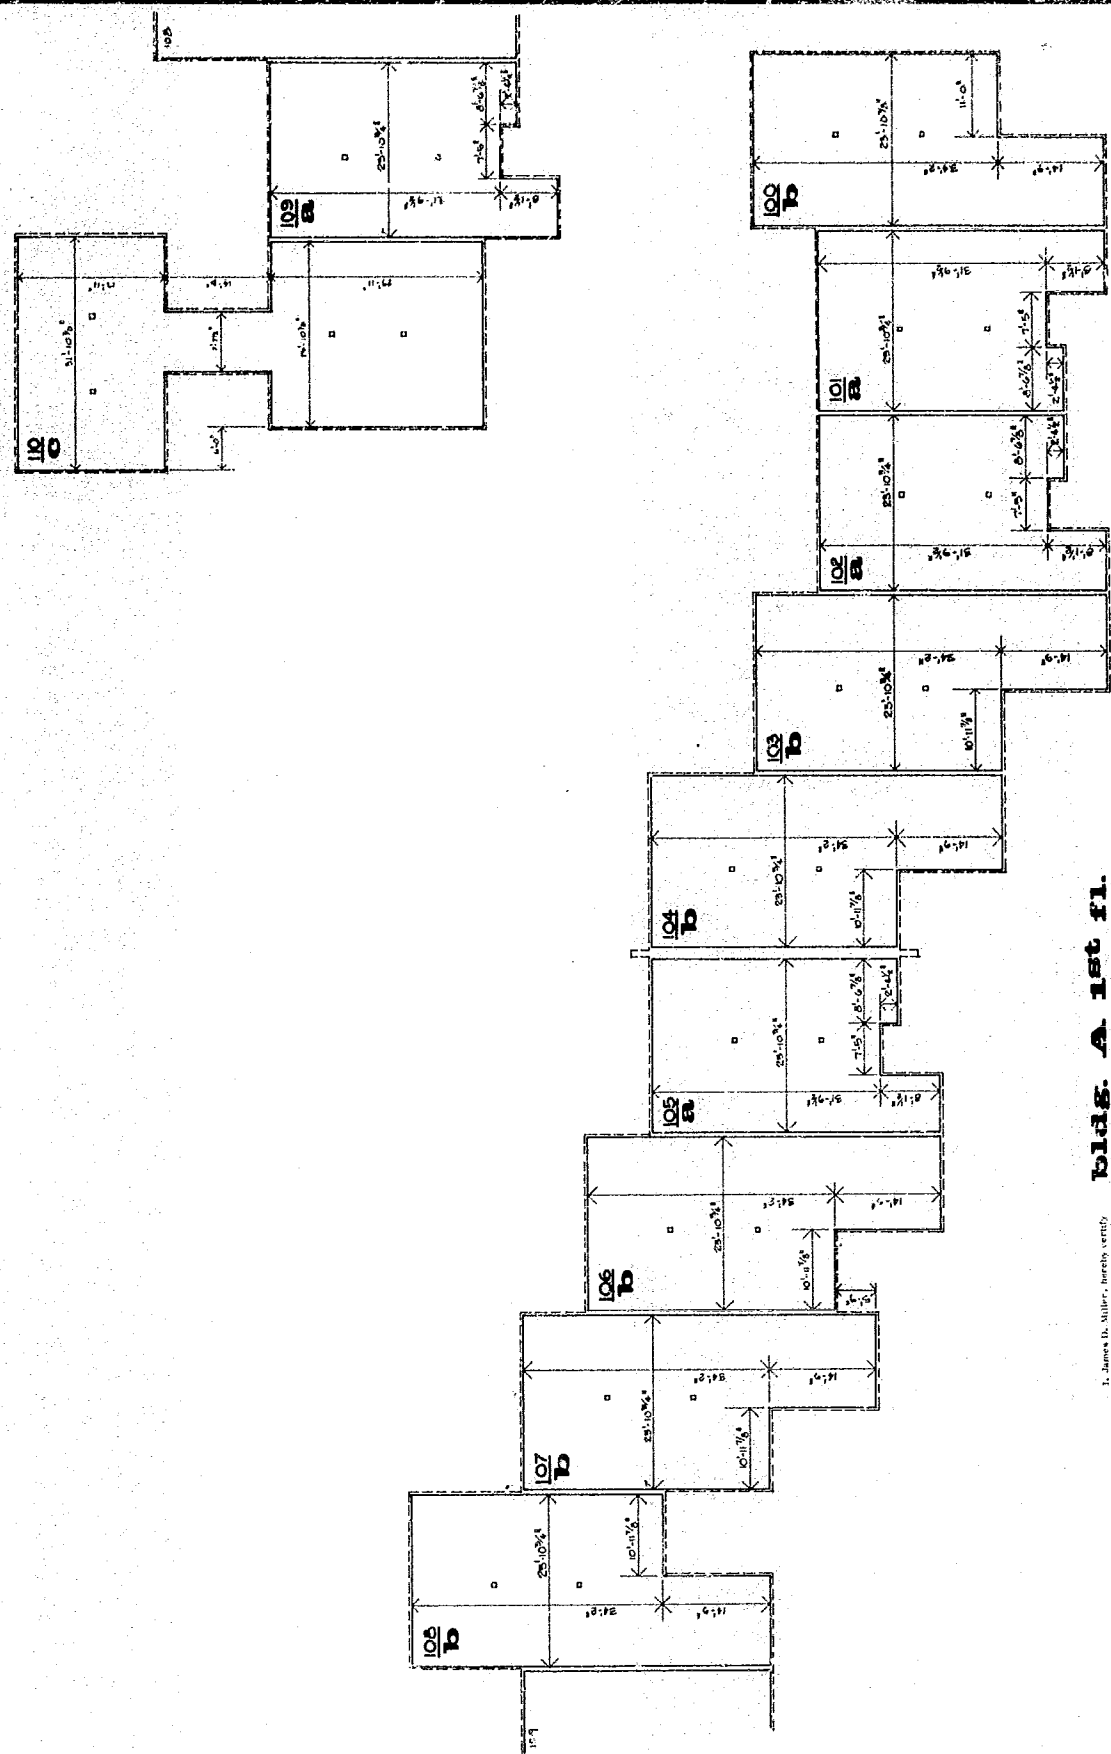

INCLEWOOD HORIZONTAL PROPERTY REGIME

BLDG. A 1ST FL.

J. James B. Miller, hereby certifies that this drawing is a true and correct copy of the original drawing as shown to the Board of my knowledge.
James B. Miller, AIA
South Carolina Registration No. 1145