









Drawn by: Checked by: Scale: 1/8" = 1'-0"

Sheet No. 11

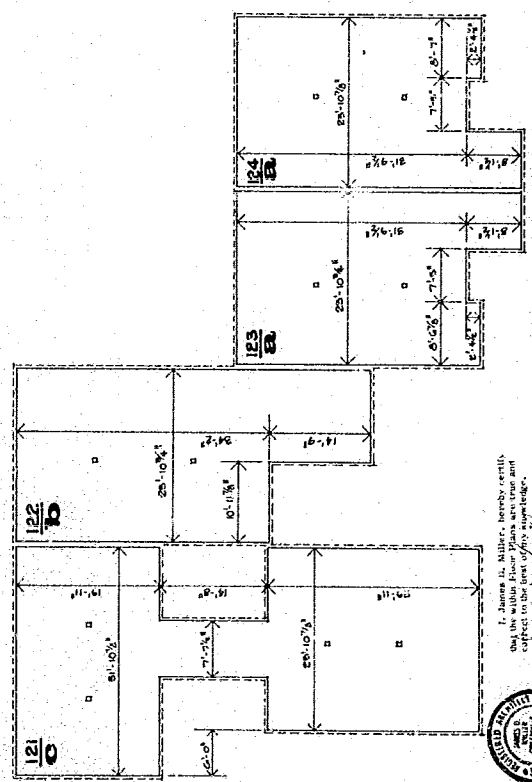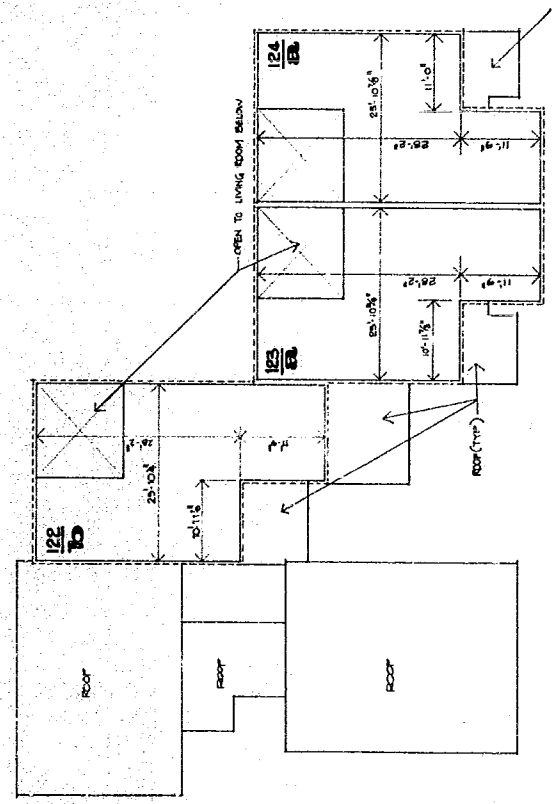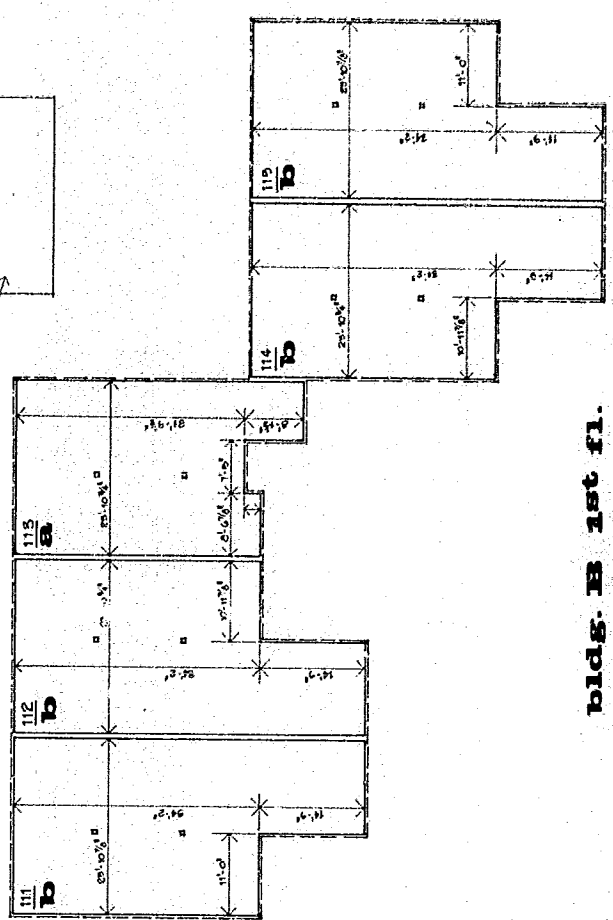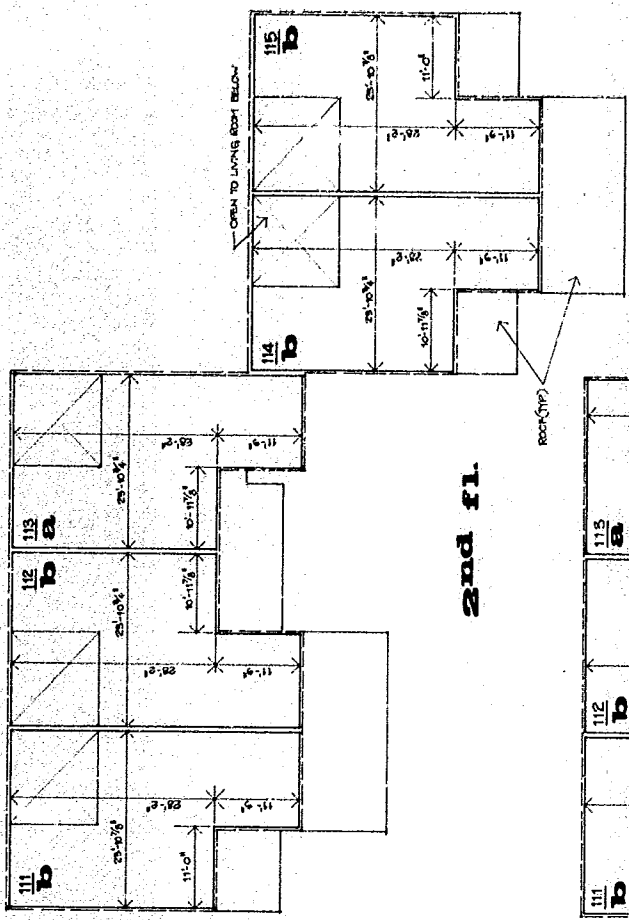

BLDG. B 1st fl.

INGLEWOOD HORIZONTAL PROPERTY REGIME

BLDG. D 1st fl.


