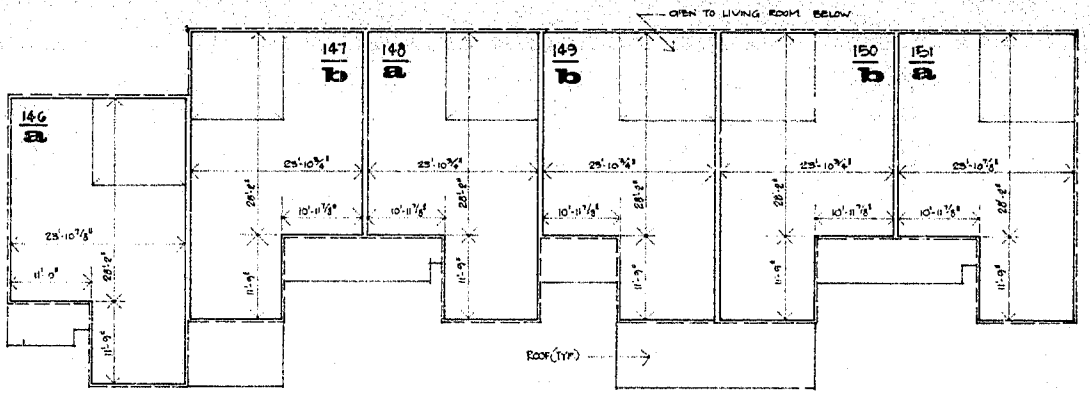

2nd fl.

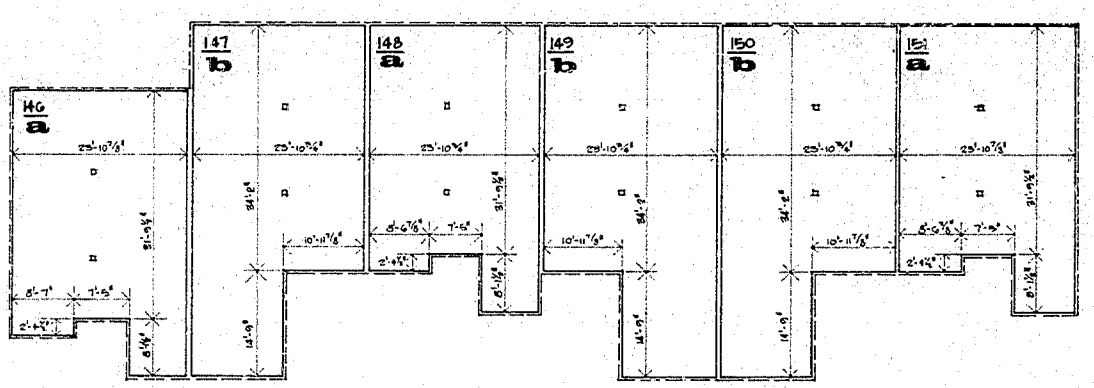

bldg. J 1st fl.

I, James D. Miller, hereby certify that the within floor Plans are true and correct to the best of my knowledge.

James D. Miller, AIA
South Carolina Registration No. 1045

INGLEWOOD HORIZONTAL PROPERTY REGIME

james d. miller & associates, architects and planners, scd.
ten ten east north street greenville s.c.
james d. miller, a.i.a.
david l. nartamore, a.i.a.

drawn by:
checked by:
scale:
job no.
date:
revised

EXHIBIT "B"

sheet
of