




J. D. Miller & Assoc. Inc.
Architects and Engineers
100 West


Approved by:
[Signature]
[Signature]
[Signature]

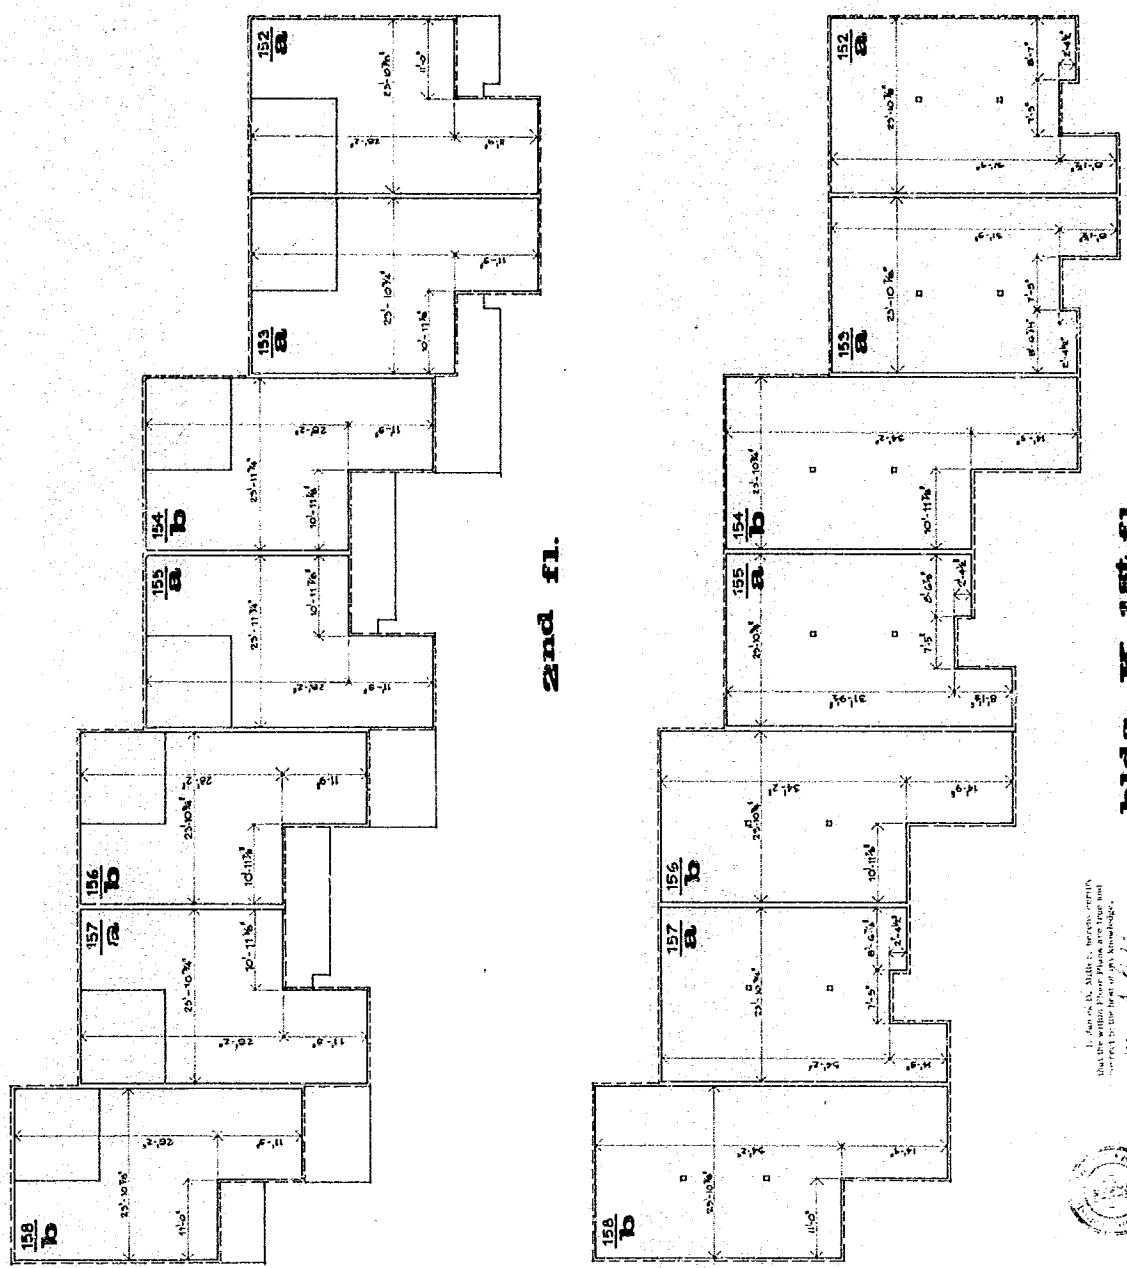

bldg. H 2nd fl.
INGLEWOOD HORIZONTAL PROPERTY REGIME

I, J. D. Miller, A.S.T., hereby certify that the within Floor Plans are true and correct to the best of my knowledge.
J. D. Miller, A.S.T.
South Carolina Registration No. 1843

