

Name and Post Office Address of Grantor: James E. & Wanda H. Howard  
McElhany Road  
Travelers Rest, South Carolina 29690

Toll Line or Exchange Line tributary to: Travelers Rest


The Property is bounded where the line enters and leaves this property by the property of:  
SCHD Rd 23-103 on the south  
and Brown Enterprises on the north

Authority: 33-2123 Ex 443-1121 Classification: 245-C  
Area: South Carolina

Approved: \_\_\_\_\_  
Title: District Engineer

OCT 15 1974 9778  
K

(1)

 

James E. Howard  
Wanda H. Howard

To

Southern Bell Telephone  
& Telegraph Co.

RECORDED OCT 15 '74 9778

Filed for record in the office of  
the R. M. C. for Greenville  
county, S. C. at 11:16 o'clock  
A. M. Oct. 15, 1974  
and recorded in Deed Book  
1008 at page 423

R. M. C. for G. Co. S. C.