BOOK 1009 PAGE 654

Name and Post Office Address of Grantor: Harold L. Foshee
828 Columbiana Road
Birmingham, Alabama 35209

File No.

Toll Line or Exchange Line tributary to: (Name) Greenville (Exchange)

The Property is bounded where the line enters and leaves this property by the property of:

Century Drive on the South East

and Century Plaza Drive on the North East

Authority 443-1940 Classification 945-C

Area South Carolina

Approved

Title District Engineer

NORTH

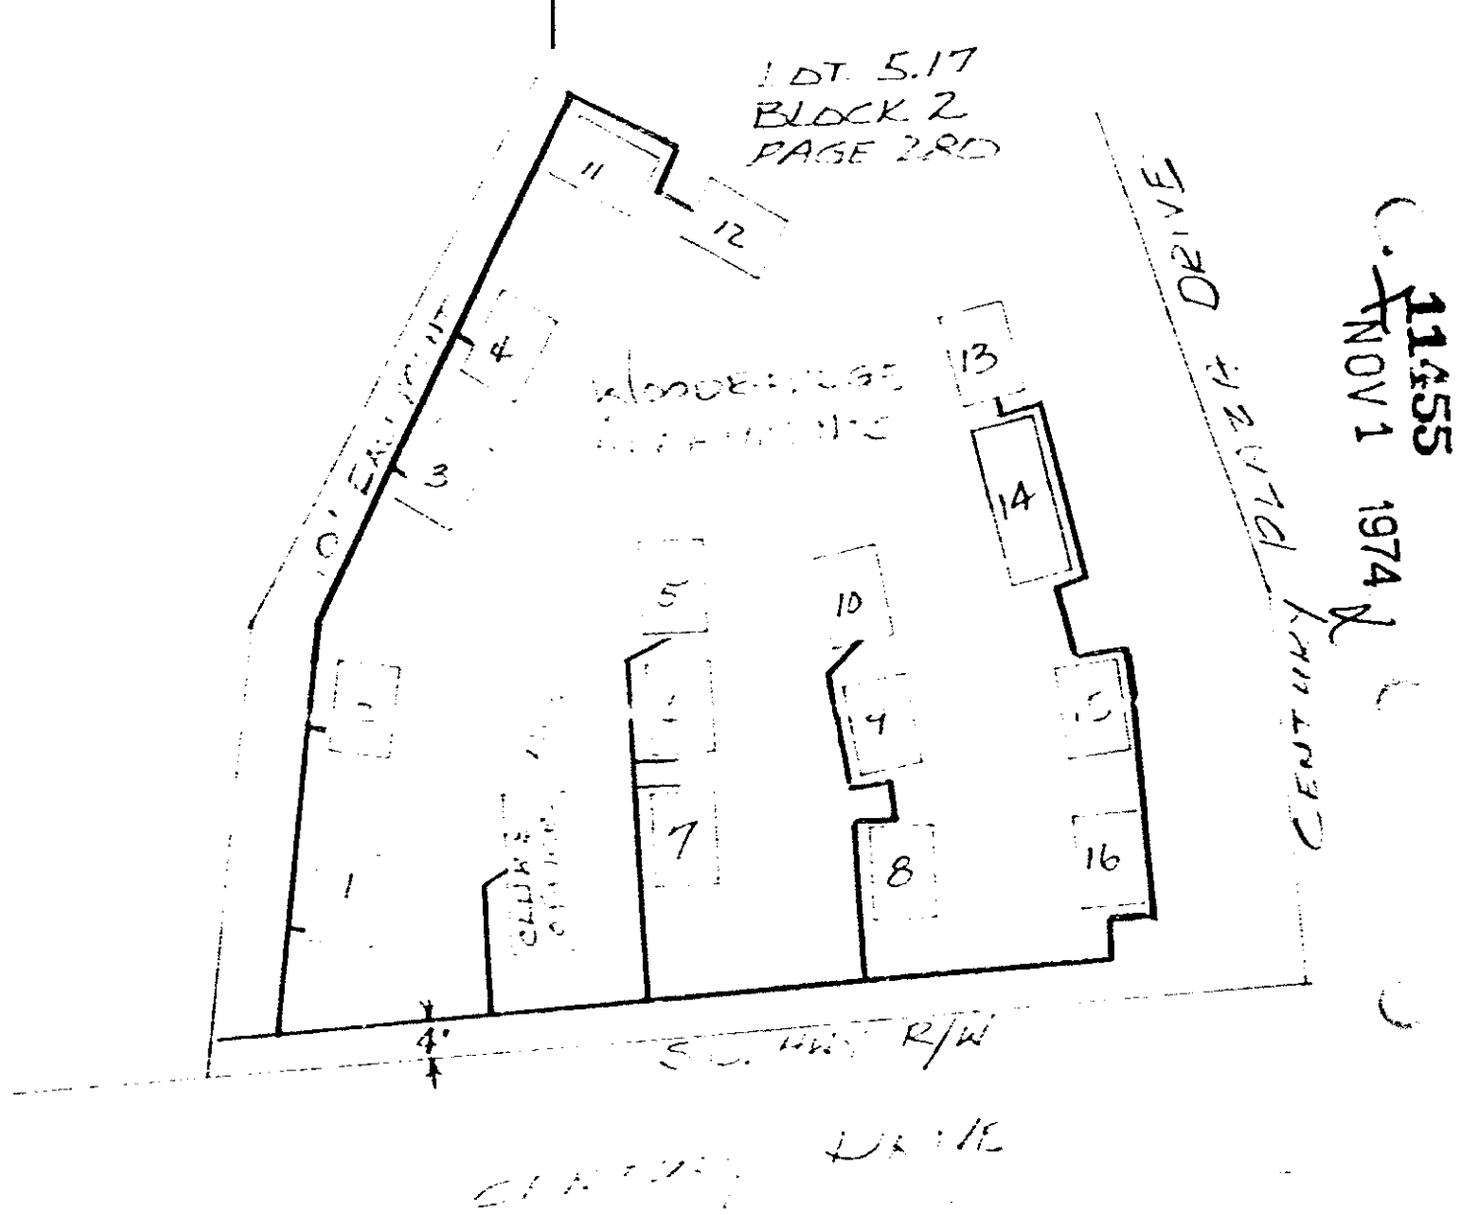

Right of Way Easement

RECORDED NOV 1 '74 11455

Filed for record in the office of the R. M. C. for Greenville County, S. C. at 11:28 o'clock A. M. Nov. 1, 1974 and recorded in Deed Book 1009 at page 654

R. M. C. for G. Co. S. C.

11455
NOV 1 1974

4328 RV.2