


Name and Post Office Address of Grantor Richard W. & Grace P. B. Costello
Route 2
Greenville, South Carolina

Toll Line _____ (None)
 or Exchange Line Woodruff Road Office of Greenville Exchange
 tributary to _____ (Exchange)

The Property is bounded where the line enters and leaves this property by the property of:
Lourie M. Hooks on the North
 and Bridges Road on the South
 Authority S-7291 Classification 945-C

Area South Carolina
 Approved District Engineer
 Title _____

Right of Way Easement

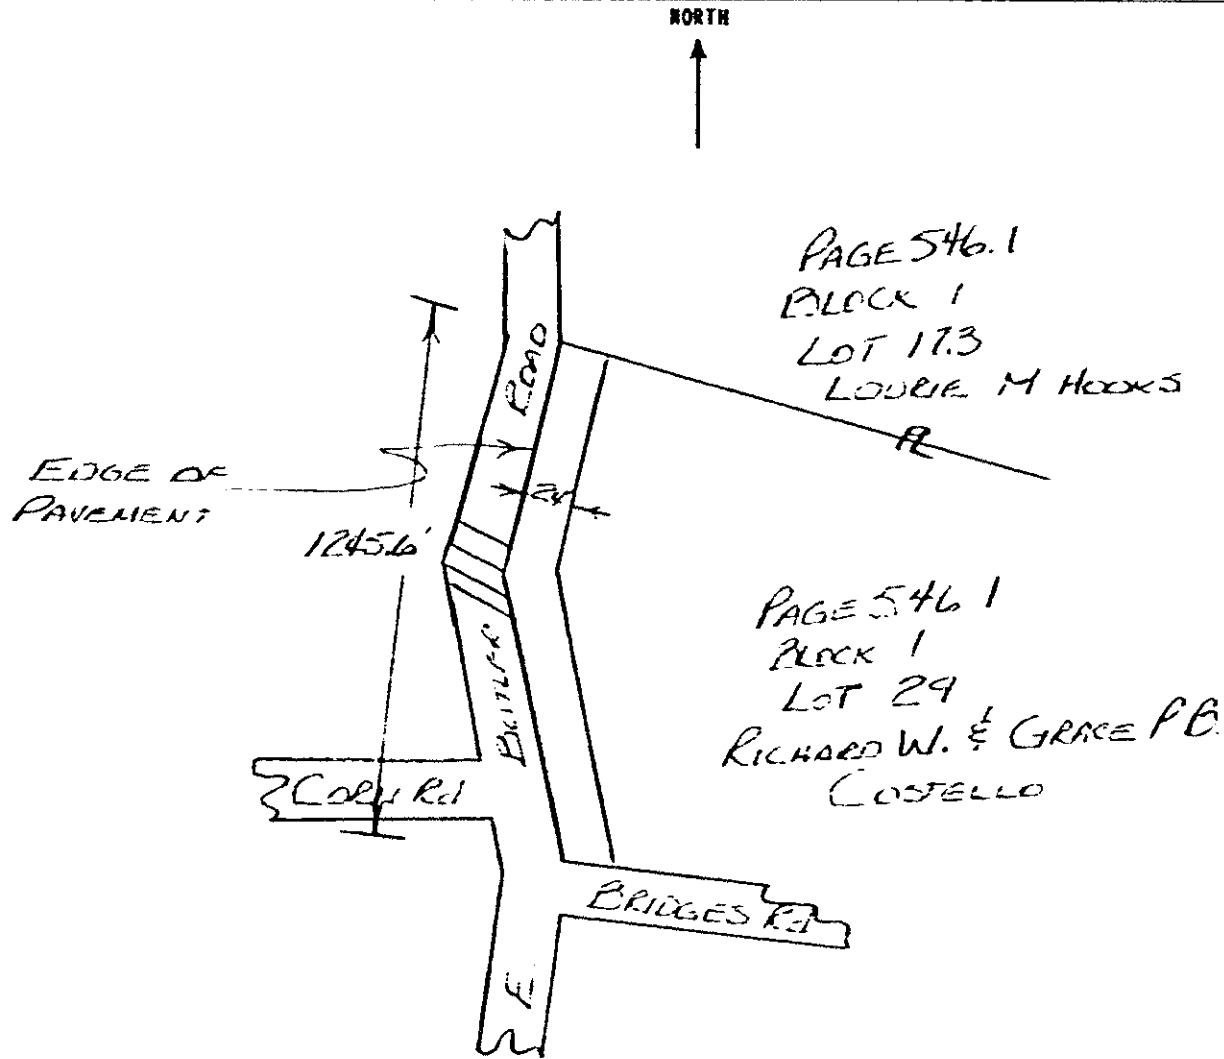

NOV 1 1974
11452

RECORDED NOV 1 '74 11452

Filed for record in the office of
the R. M. C. for Greenville
county, S. C. at 11:28 o'clock
A. M. Nov. 1, 1974
and recorded in Deed Book
1009 at page 667

R. M. C. for G. Co. S. C.

*Richard W. & Grace P. Costello
To
Lourie M. Hooks*