


0762

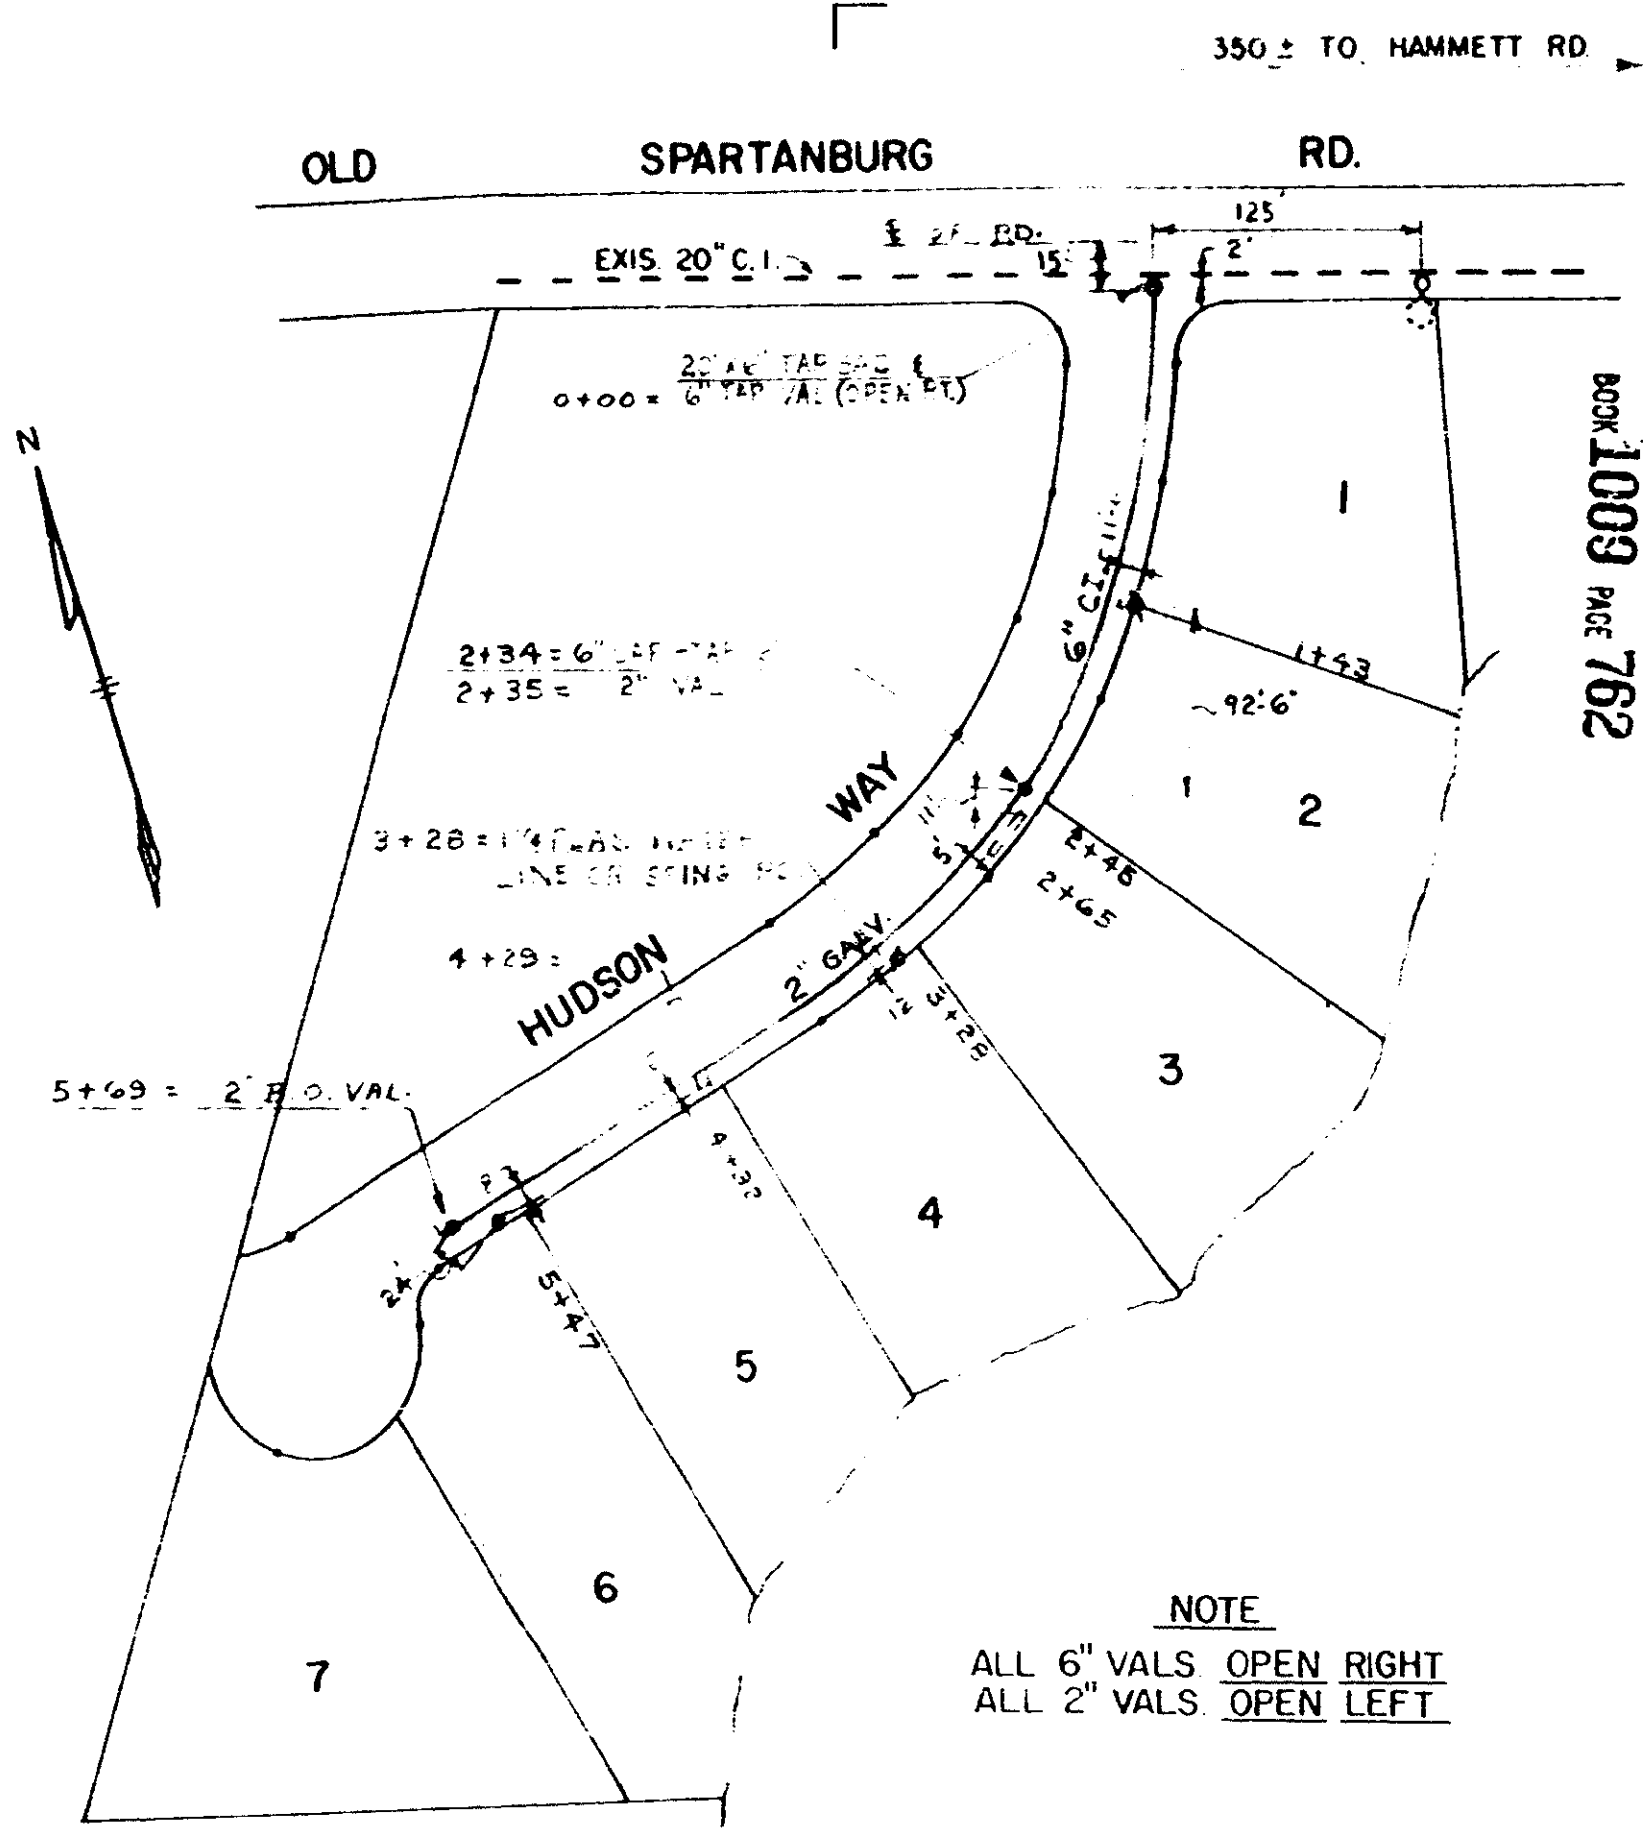

BOOK 1009 PAGE 762

NOTE
 ALL 6" VALS. OPEN RIGHT
 ALL 2" VALS. OPEN LEFT

Material List.

6" C. I. Pipe	-	240'
2" Galv. Pipe	-	335'
6" Valve	-	1
2" Valves	-	2

HUDSON WAY
 JUNE, 1974 SCALE 1"=100'
 Mr. John Boer
 to
 Commissioners of Public Works
 of the City of Greenville, S. C.
 October 7, 1974
 BLK. B. 538.7-1-57 & 58

Deed and Plat RECORDED NOV 6 '74 11744

4328 RV-2