


REF 9349

VOL 1026 PAGE 340

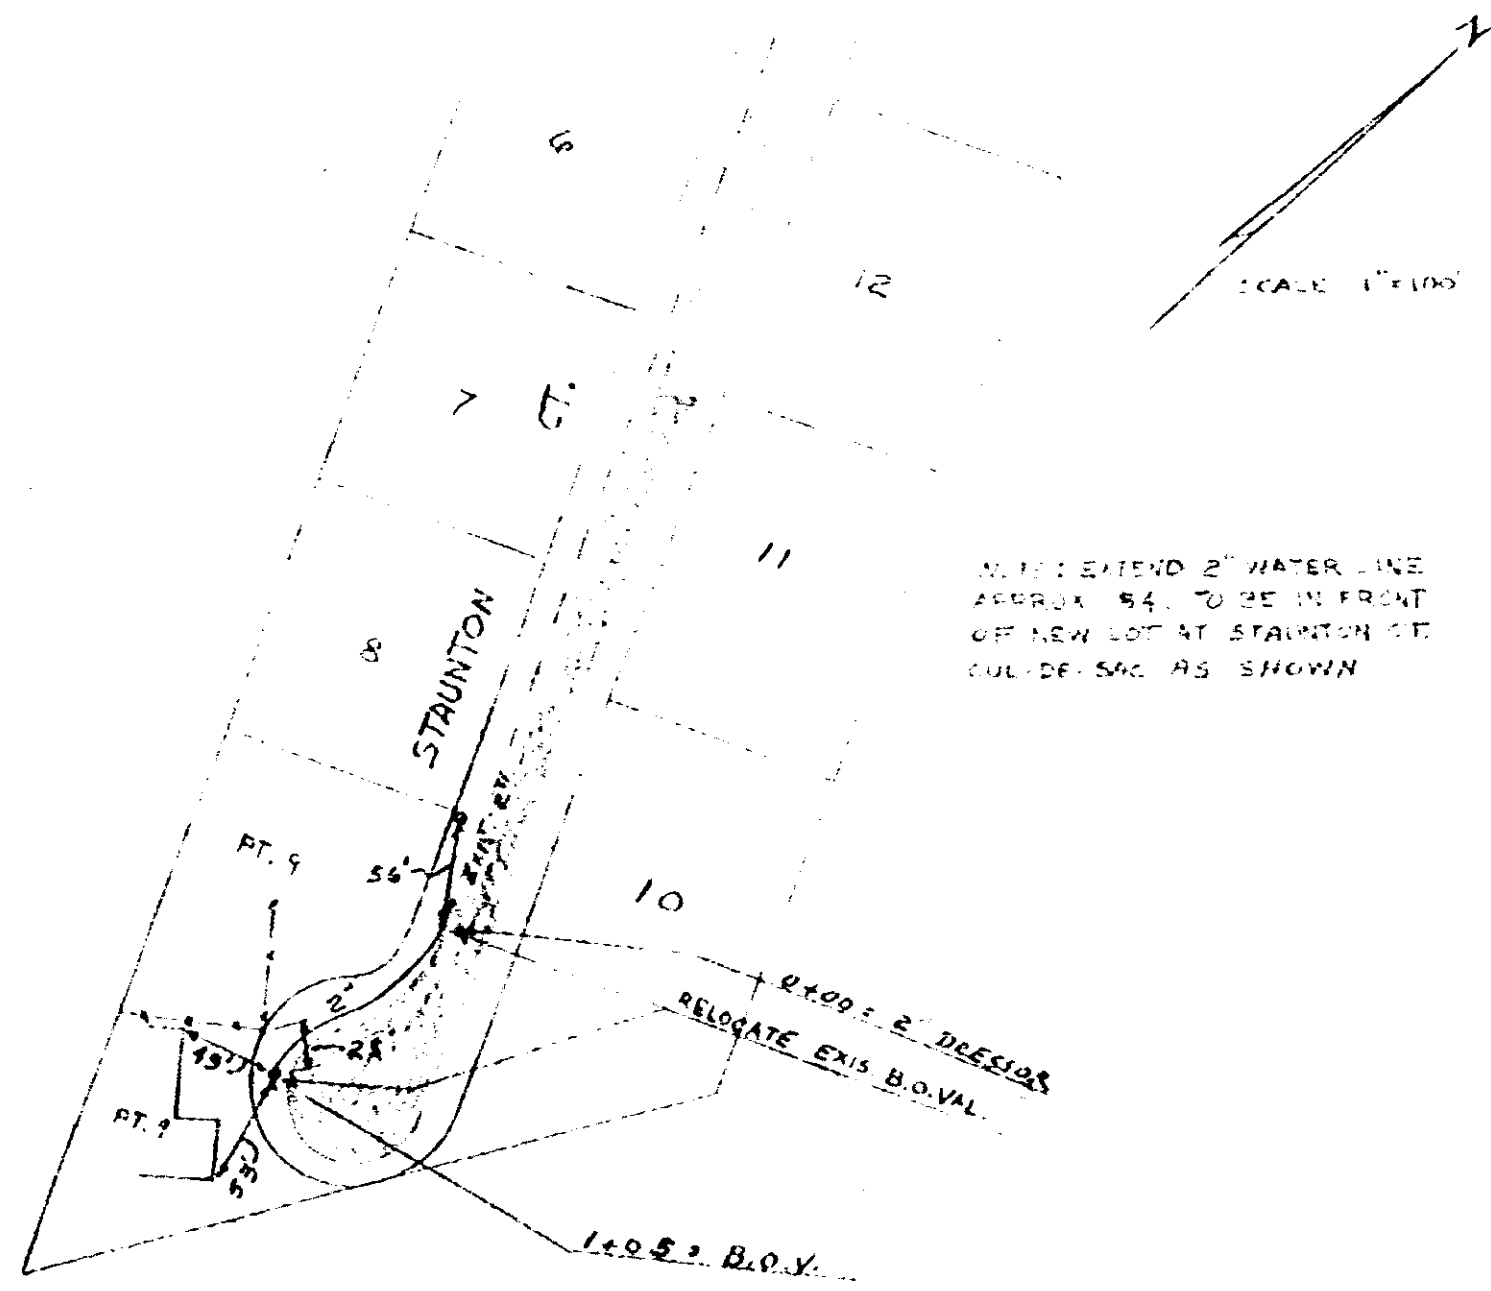

N. 17: EXTEND 2" WATER LINE APPROX 54' TO BE IN FRONT OF NEW LOT AT STAUNTON CT. CUL-DE-SAC AS SHOWN

RELOCATE EXIS B.O.VAL. TO 1+09 = 2" DESSORS

1+05 = B.O.V.

Material List:

2" Galv. Pipe - 105'

STAUNTON CT.

Charles Uton
to
Commissioners of Public Works
of the City of Greenville, S. C.
October 14, 1975

RECORDED OCT 24 '75 at 12:04 P.M. 11004

4328 RV-2