


Name of Property JOHN KEARLE  
304 NORTH CHURCH STREET  
GREENVILLE, SOUTH CAROLINA  
 Exchange Line GREENVILLE  
 Tributary to \_\_\_\_\_  
 The Property is bounded where the line enters and leaves this property by the property of  
DUNEAN MILL on the WEST  
WEST FARIS ROAD on the SOUTH  
 Locality 543-2068 Classification 945-C  
GREENVILLE, SOUTH CAROLINA  
 Approved [Signature]  
 DISTRICT ENGINEER

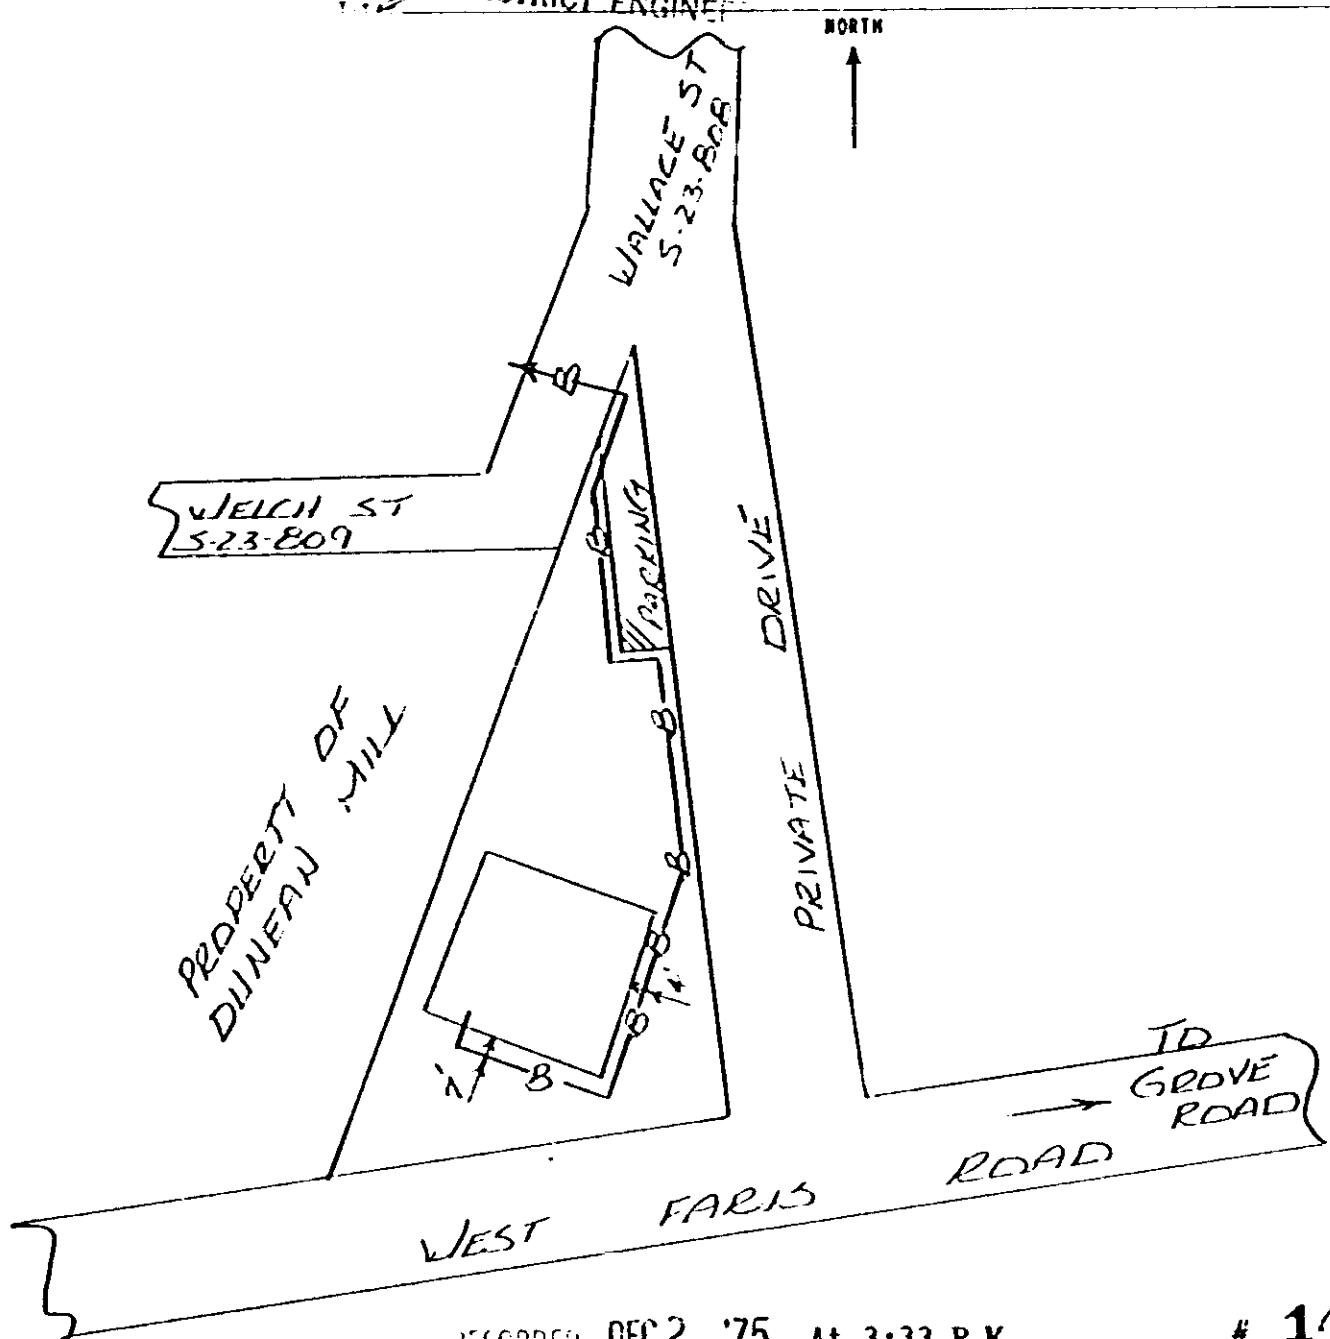

RECORDED DEC 2 '75 At 3:33 P.M.

# 14368

M. C. for G. Co. S. C.

1027 at page 972

Filed for record in the office of  
 the R. M. C. for Greenville  
 County, S. C. at 3:33 P.M.  
 Dec. 2, 1975

DEC 2 1975

14368

2-N 823

5260