
- 14 Mg

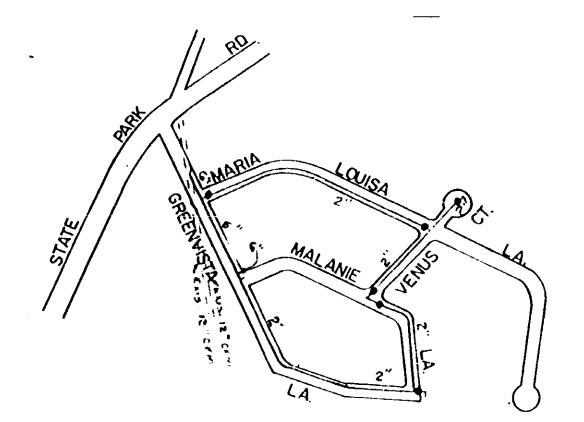

va 1028 ran 123

Material List:

> J. G. Jones, . E. Rish, and A. G. Jones to Piedmont Park Fine District May, 1975

RECORDED DEC 4 '75 at 3:05 P.M.

14593

1000 EV.2