

Name and Post Office Address of Grantor: **Dee Smith Company, Inc.**
2003 Laurens Road
Greenville, S. C.

Toll Line or Exchange Line tributary to: **Greenville**

The Property is bounded where the line enters and leaves this property by the property of:
Devenger Road on the **south side**
 and **Fred H. Hudson** on the **north side**


Authority: **S-8175** Classification: **945-C**

Area: **S. C.**

Approved: **District Engineer** *[Signature]*

Title: **D. E.**

NORTH

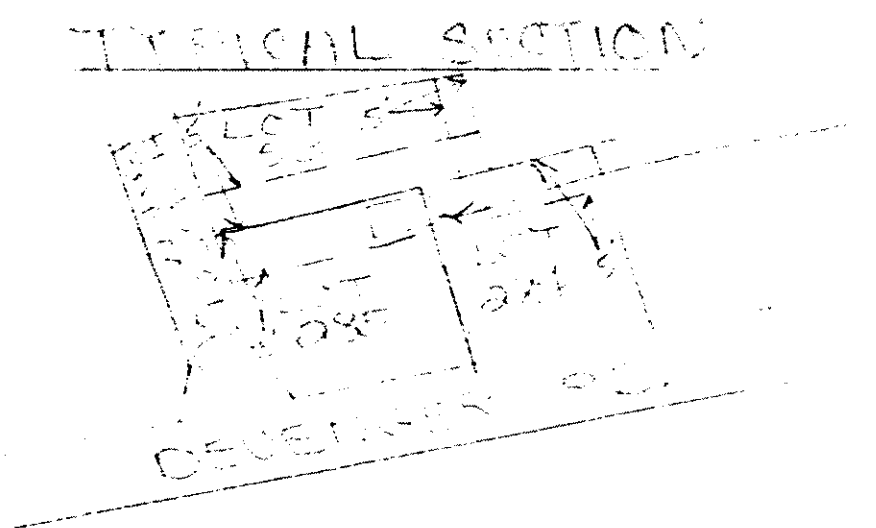

LOCATION OF INTERFACE

APR 9 1976
25961

RECORDED APR 9 '76 At 1:09 P.M. 25961

Pls Enclosed

*Devenger Road Lands Co. acts
Southern Bell Telephone & Telegraph Co.*

Filed for record in the R. M. C. for Greenville, S. C. at 1:09 P.M. April 9, 1976 and recorded in bond for 103L at page 176

R. M. C. for G. Co. S. C.