


Vol 1035 Page 330

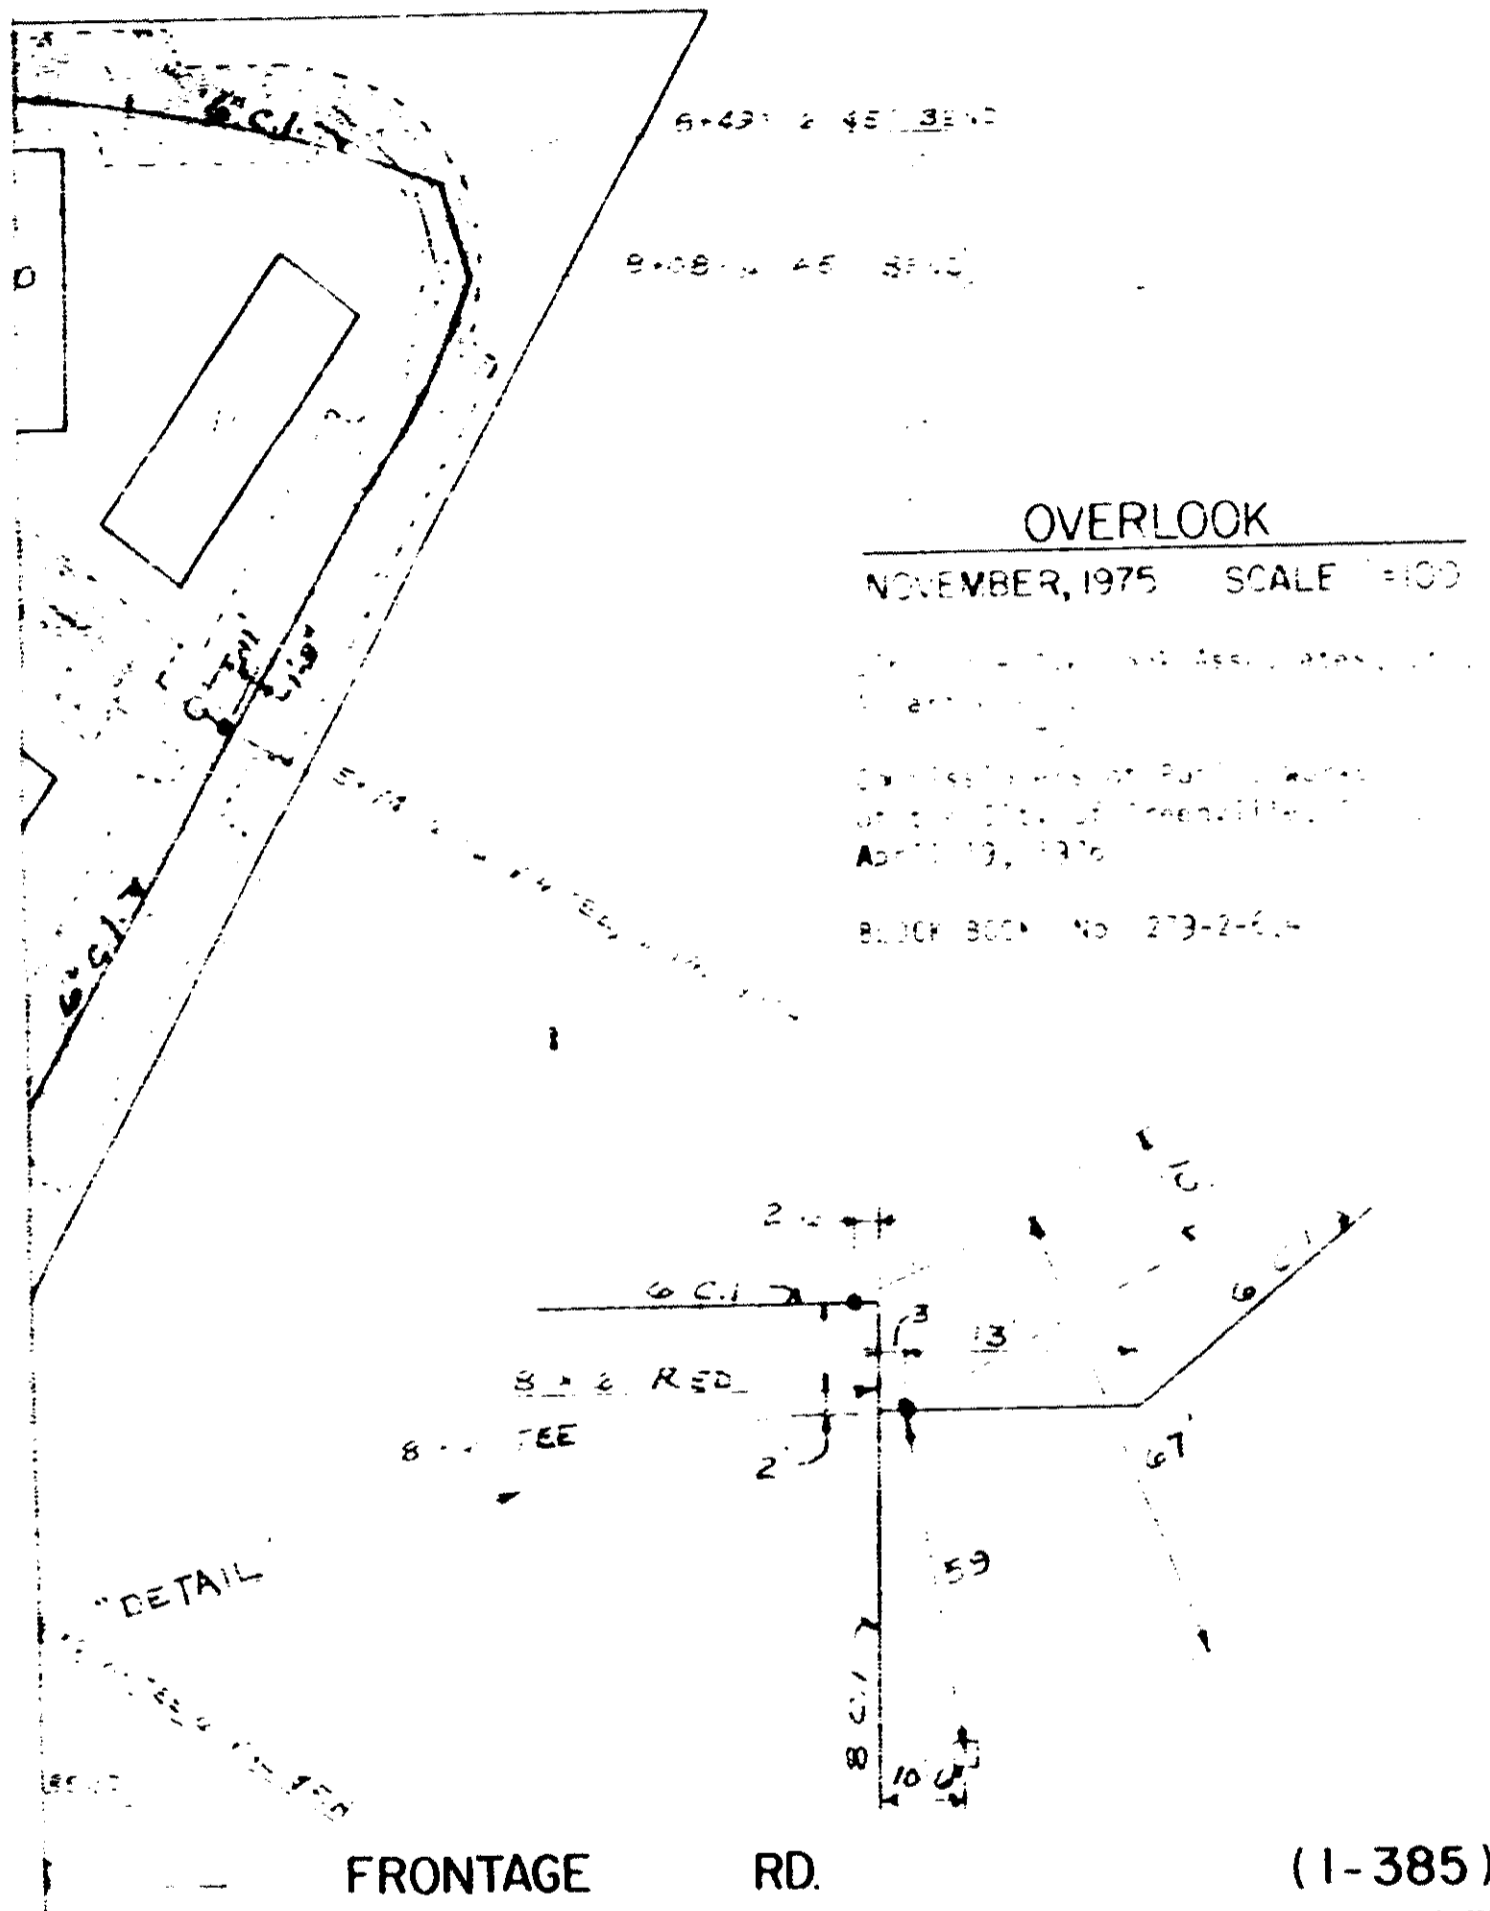

OVERLOOK

NOVEMBER, 1975 SCALE 1"=100'

 Date: April 19, 1976
 Block Book No. 279-2-61-4

NOTE: ALL 6" & 8" VALVES OPEN RIGHT
 ALL FIRE HYDRANTS TO BE 3-WAY & OPEN RIGHT

RECORDED APR 27 '76 At 3:24 P.M.

27073

4328 RV-21

0339