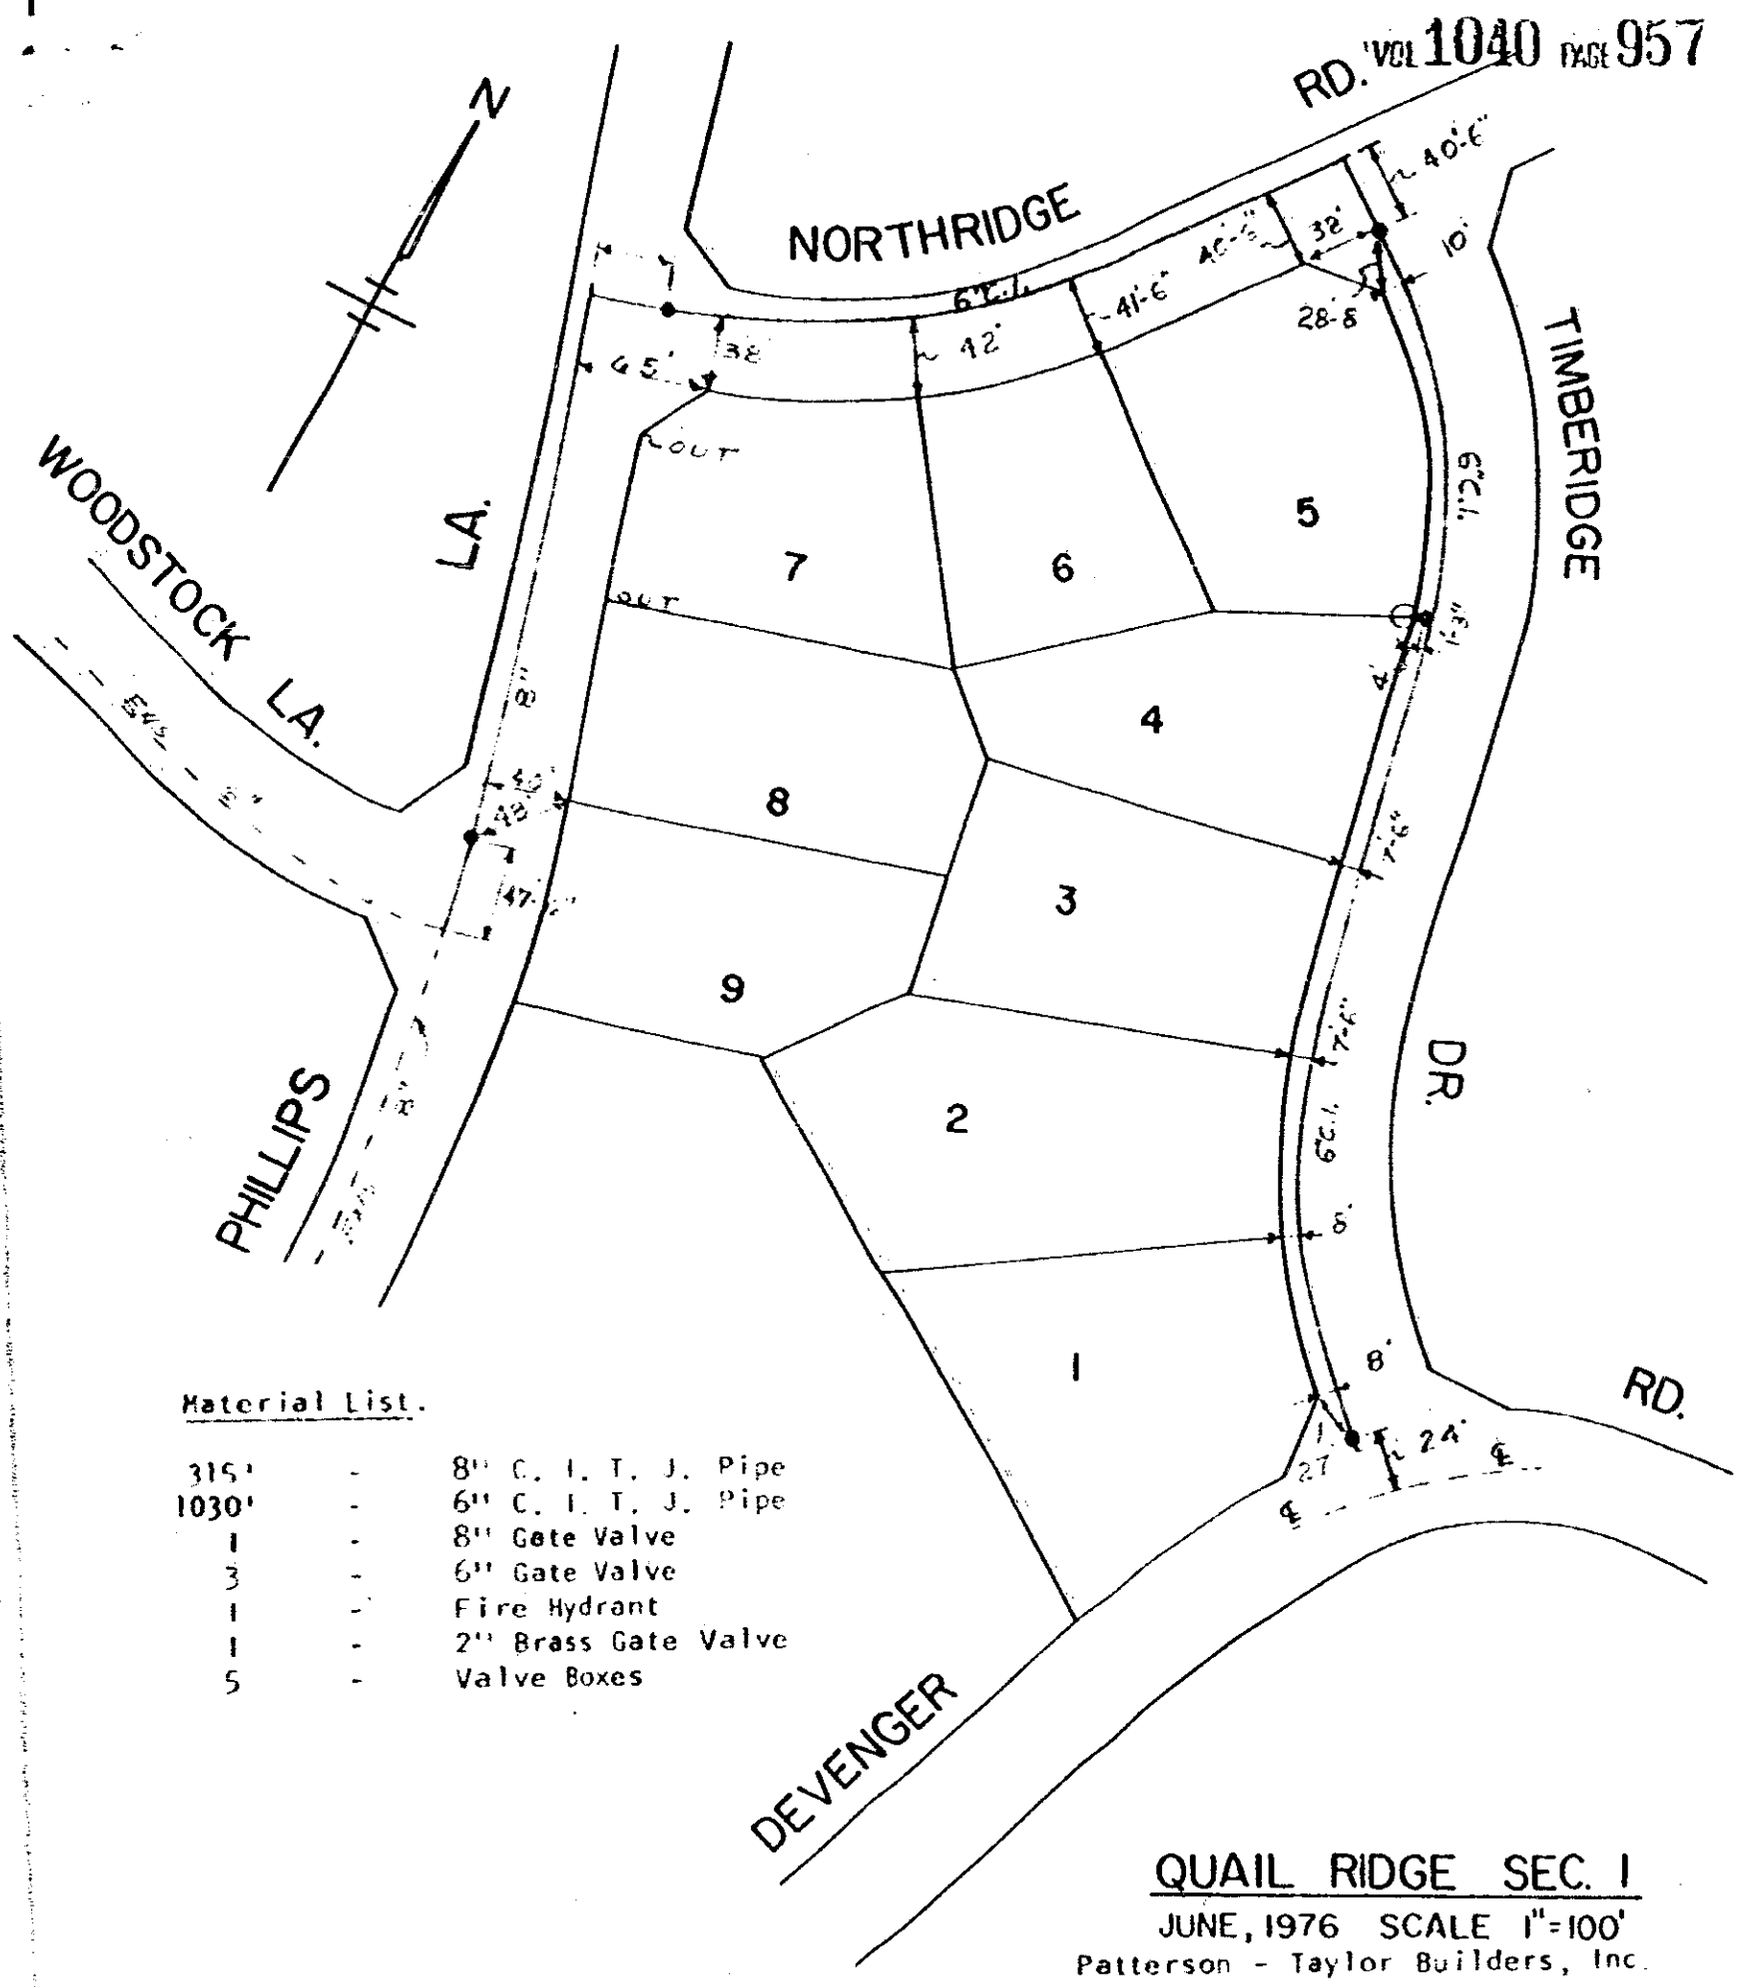


Material List.

| | | |
|---|---|---|
| 315' | - | 8" C. I. T. J. Pipe |
| 1030' | - | 6" C. I. T. J. Pipe |
| 1 | - | 8" Gate Valve |
| 3 | - | 6" Gate Valve |
| 1 | - | Fire Hydrant |
| 1 | - | 2" Brass Gate Valve |
| 5 | - | Valve Boxes |

QUAIL RIDGE SEC. I

JUNE, 1976 SCALE 1"=100'

Patterson - Taylor Builders, Inc.

to

Commissioners of Public Works
of the City of Greenville, S. C.
July 26, 1976

Block Book No. 540.3-1-17.1

Recorded August 9, 1976 at 4:31 P/M 3848

4328 RV.2