0256

4328 RV-2

VOL 1042 PAGE 256

Middleton Place

HORIZONTAL PROPERTY REGIME

PLOT PLAN

GREENVILLE COUNTY, SOUTH CAROLINA

ROBERT R. SPEARMAN, REG. L.S. # 3615

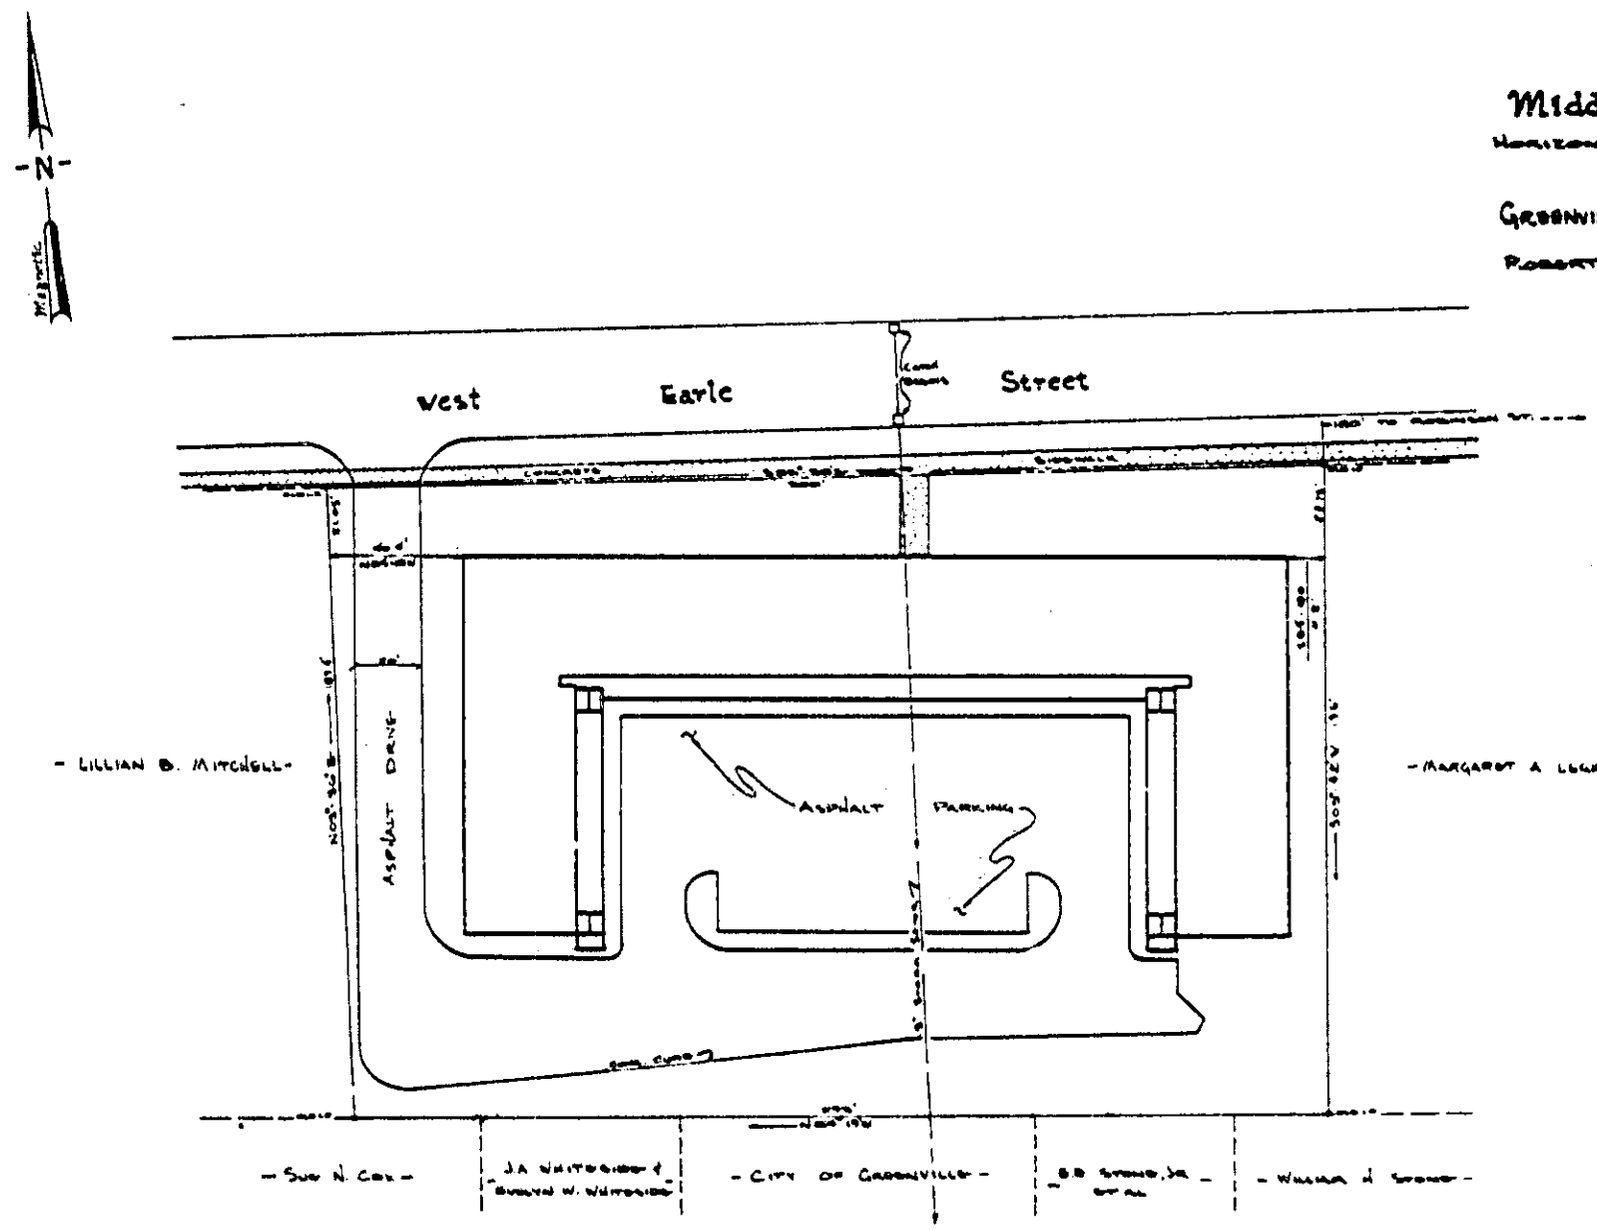

THE UNDERSIGNED CERTIFIES THAT THE BOUNDARY FOR THE PROPERTY WAS SHOWN FROM AN ACTUAL SURVEY DATED AUGUST 20, 1976 MADE BY ME AND THAT THE COURSES AND DISTANCES ARE TRUE AND CORRECT, THAT THE BUILDING AND IMPROVEMENTS LOCATED THEREON ARE ACCURATELY LOCATED, THAT THE BUILDING AND IMPROVEMENTS DO NOT ENCROACH OR PROJECT OVER THE BOUNDARY LINES.

REGISTERED LAND SURVEYOR NO. 3615

AUGUST 20, 1976

SOUTH CAROLINA REGISTERED LAND SURVEYOR NO. 3615 ROBERT R. SPEARMAN

THIS PLOT PLAN SHOWS THE LOCATION OF THE BUILDING CONTAINING 30 CONDOMINIUMS IDENTIFIED AS UNITS A1 THROUGH A8 AND B1 THROUGH B8 ON THE LOWER LEVEL, AND A21 THROUGH A29 AND B29 THROUGH B30 ON THE UPPER LEVEL IN MIDDLETON PLACE HORIZONTAL PROPERTY REGIME AS ARE MORE FULLY DESCRIBED AND SHOWN ON SHEETS 2, 3, AND 4 OF THIS EXHIBIT B OF THE DECLARATION OF MIDDLETON PLACE HORIZONTAL PROPERTY REGIME.

EXHIBIT B
SHEET 1 OF 4