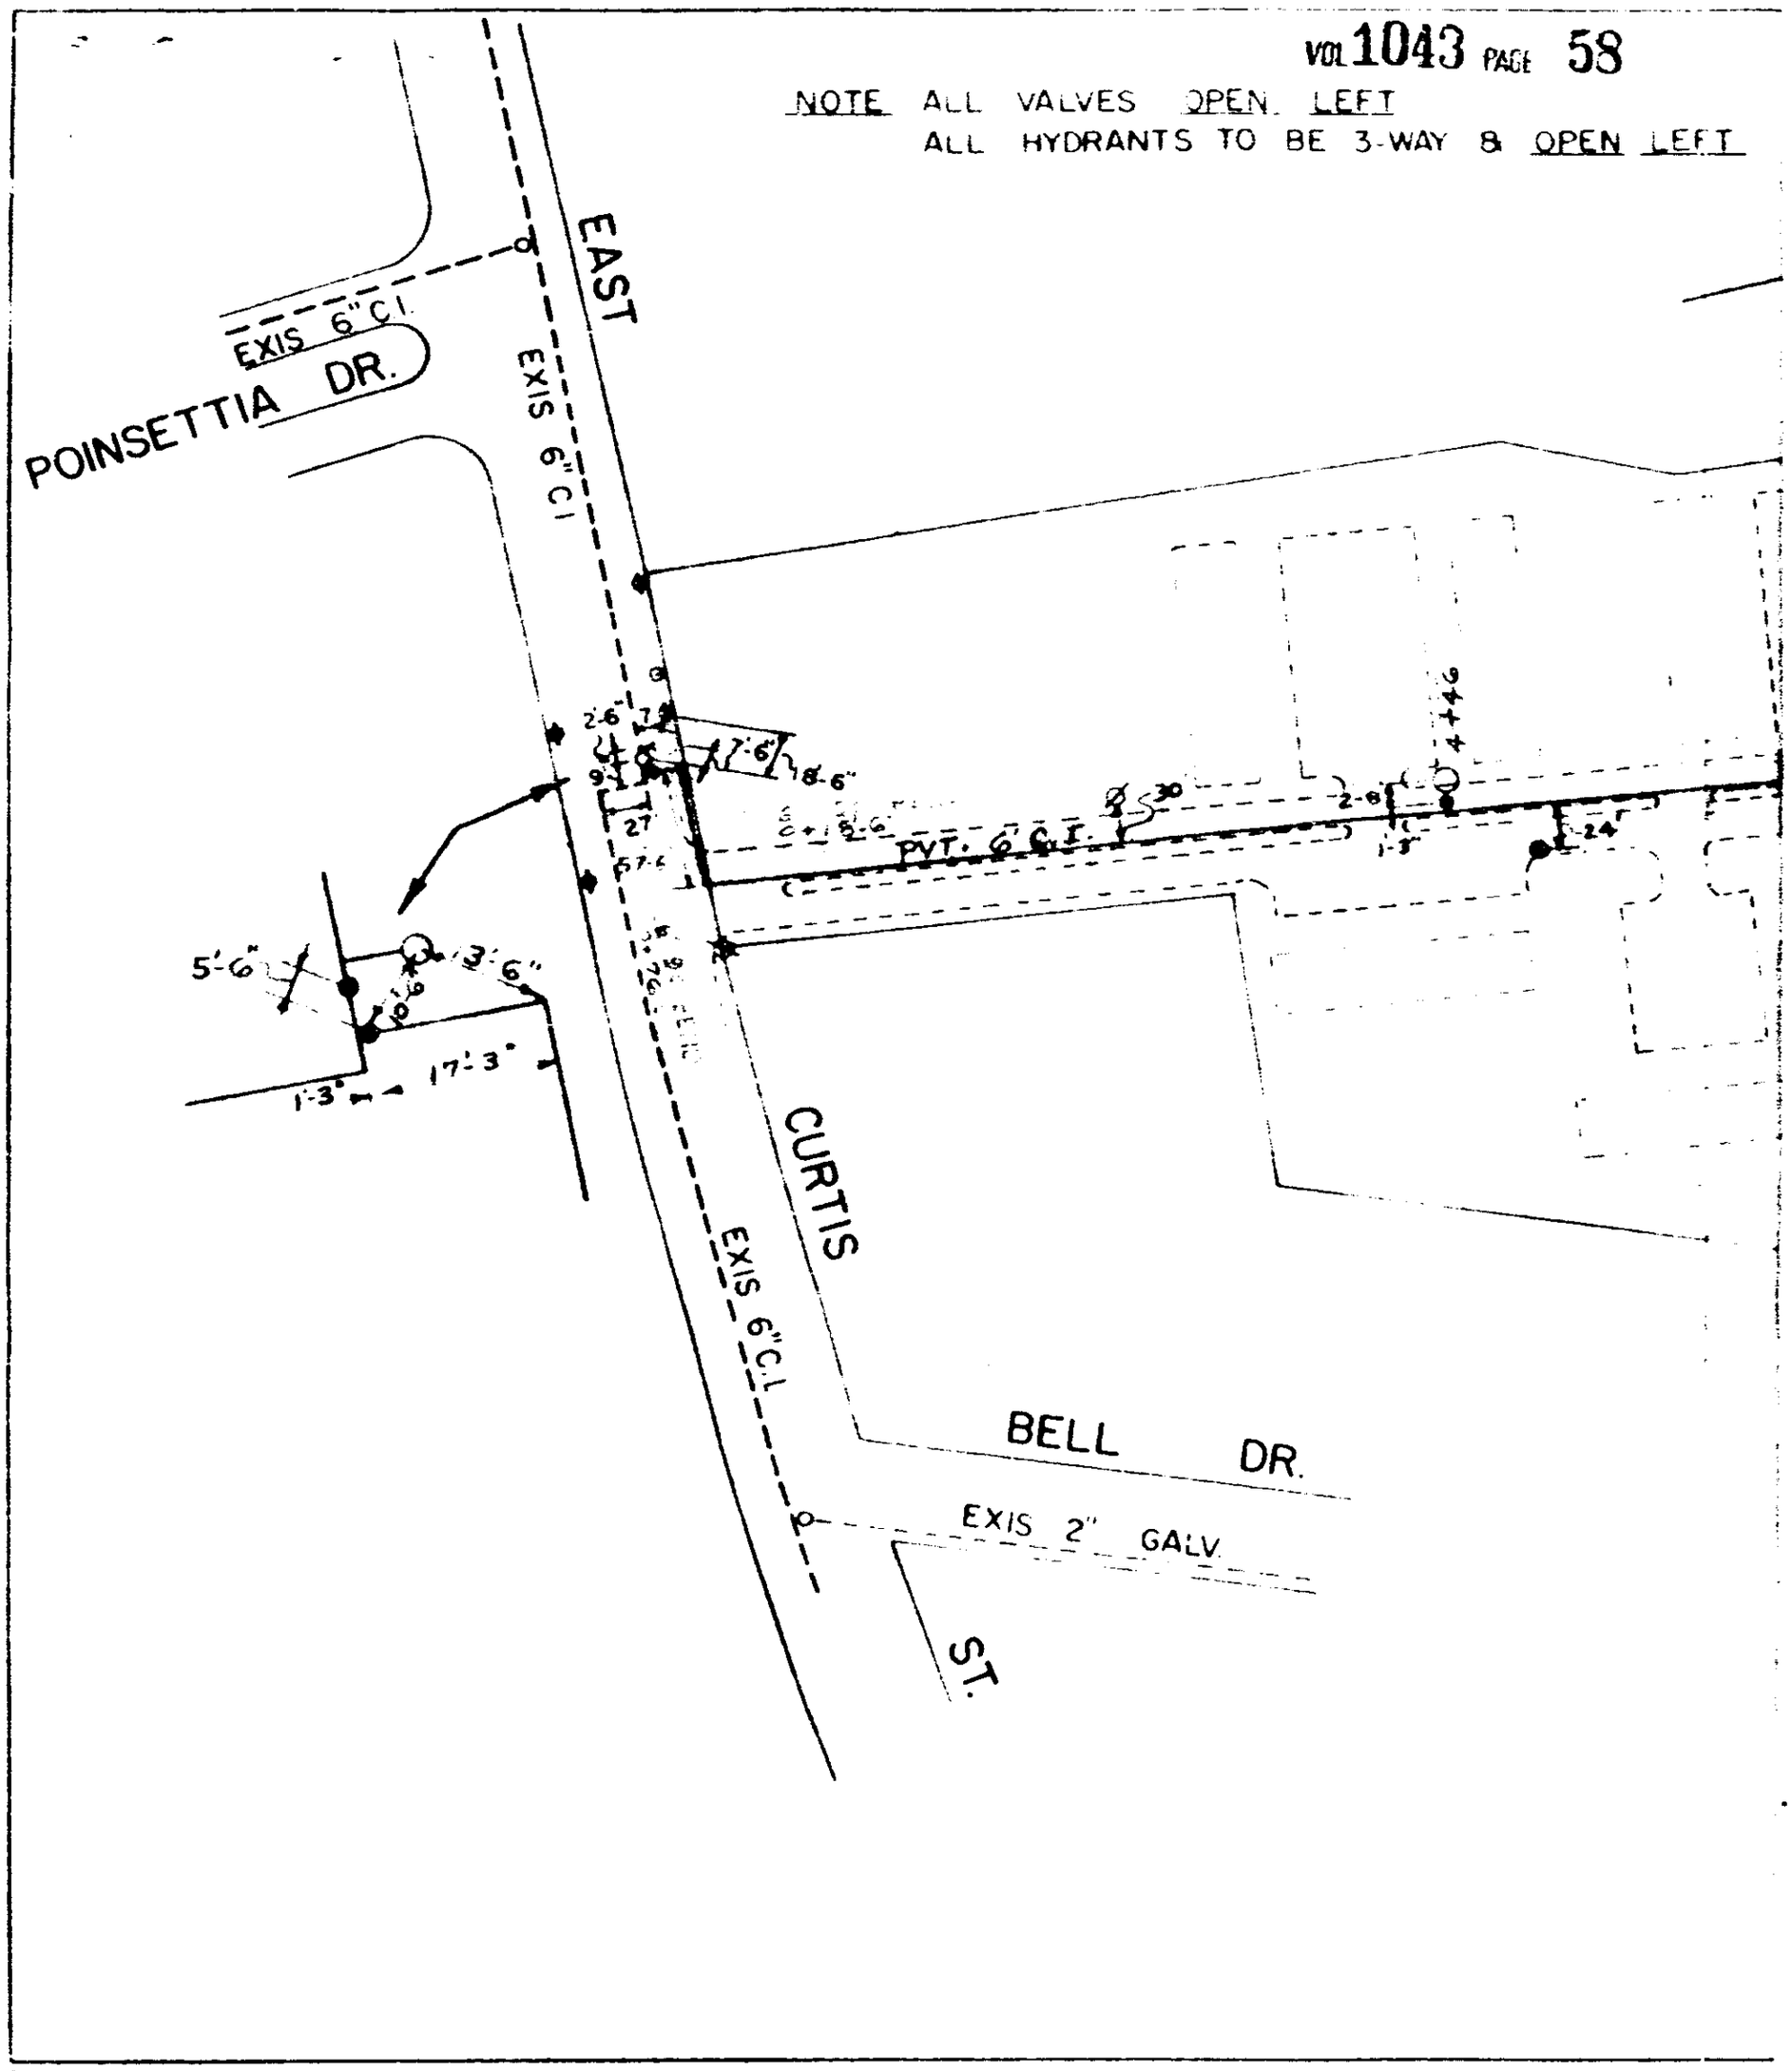NOTE ALL VALVES OPEN LEFT
ALL HYDRANTS TO BE 3-WAY & OPEN LEFT