


Name and Post Office Address of Grantor Ernest C. Capell
105 St. Augustine Drive
Greenville, S. C. 29607

Toll Line or Exchange Line tributary to Woodruff Road Wire Center

The Property is bounded where the line enters and leaves this property by the property of:
St. Augustine on the north
Peter A. & Jacquel I. Taylor on the east

Authority S-8346 Classification 945C
 Area Greenville, S. C.

Approved [Signature]
 Title District Engineer

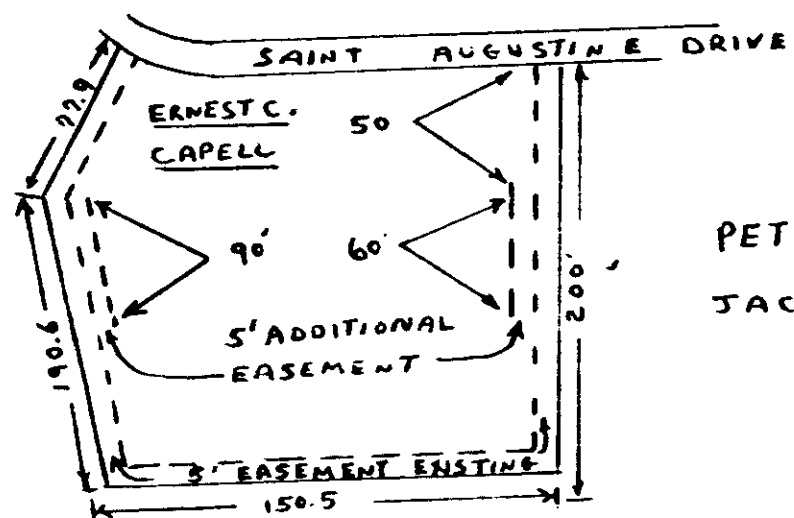

PETER A. &
 JACQUEL I. TAYLORS

Recorded October 7, 1976 at 1:54 P/M

9613

OCT 7 76

See envelope

X 19613

(5)

Filed for record in the office of
 the R. M. C. for Greenville
 County S. C. at 1:44 o'clock
 P/M Oct. 7, 1976
 and recorded in Deed Book
 1024 at page 199
 R. M. C. for G. Co. S. C.

4328 W-2