



SHERWOOD FOREST

VOL 1048 PAGE 267

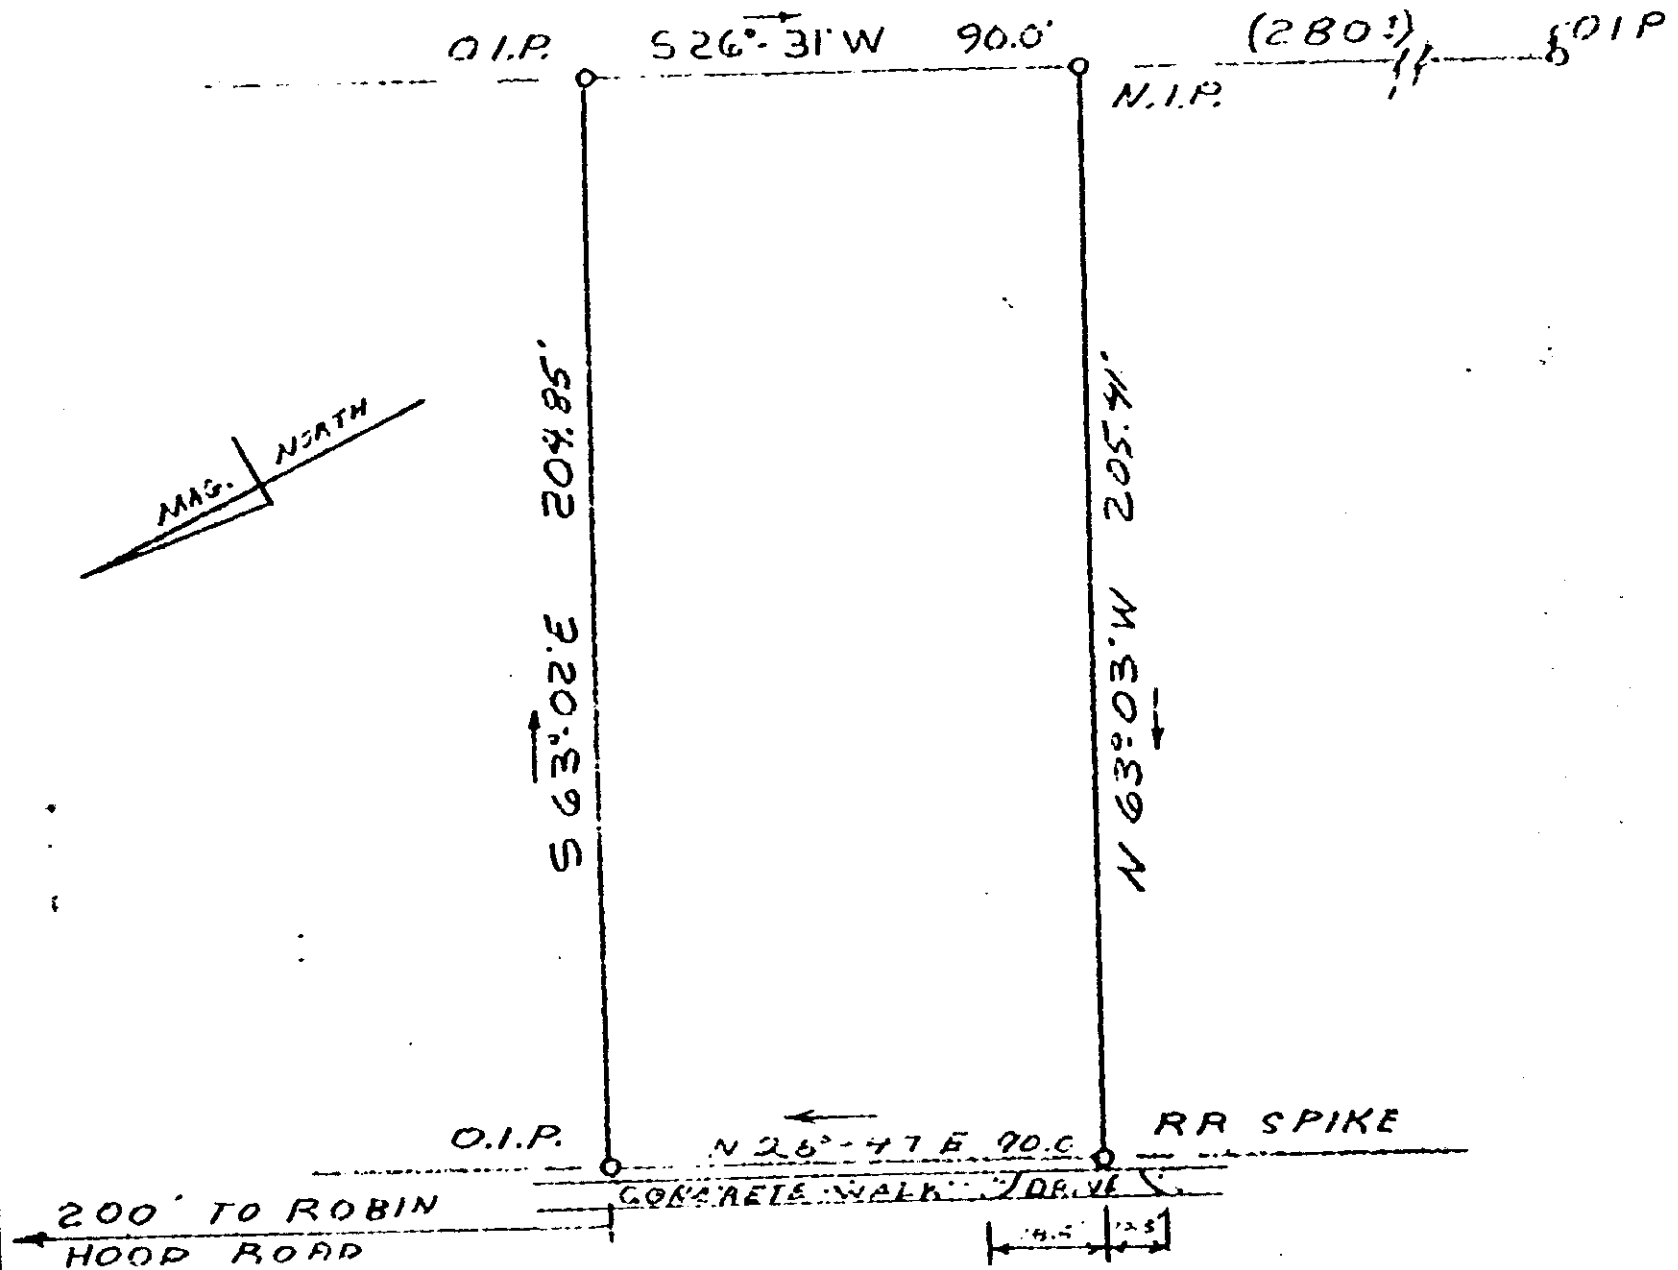

(291 BY-PASS)  
SOUTH PLEASANTBURG DRIVE

PLAT BLK. BK 265-1-11.12

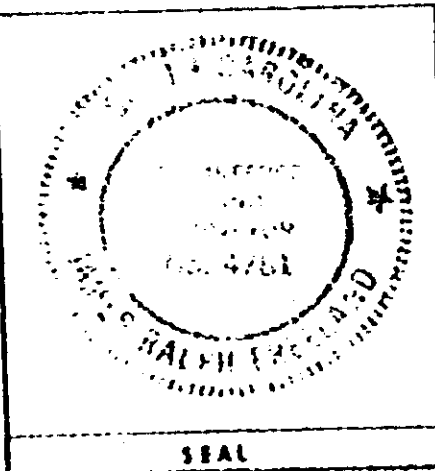

STATE OF SOUTH CAROLINA  
GREENVILLE COUNTY

FRELAND & ASSOCIATES  
Engineers & Land Surveyors

GREENVILLE, S. C.

PROPERTY OF

DAVID DOUGLAS

SURVEY FL 106

DRAWN FL

CHECK JRF

SCALE 1" = 40'

DATE 4-9-76

DWG. NO. 76-814

SEAL

RECORDED DEC 21 '76 At 1:00 P.M.

16658

267

4328 RV-23