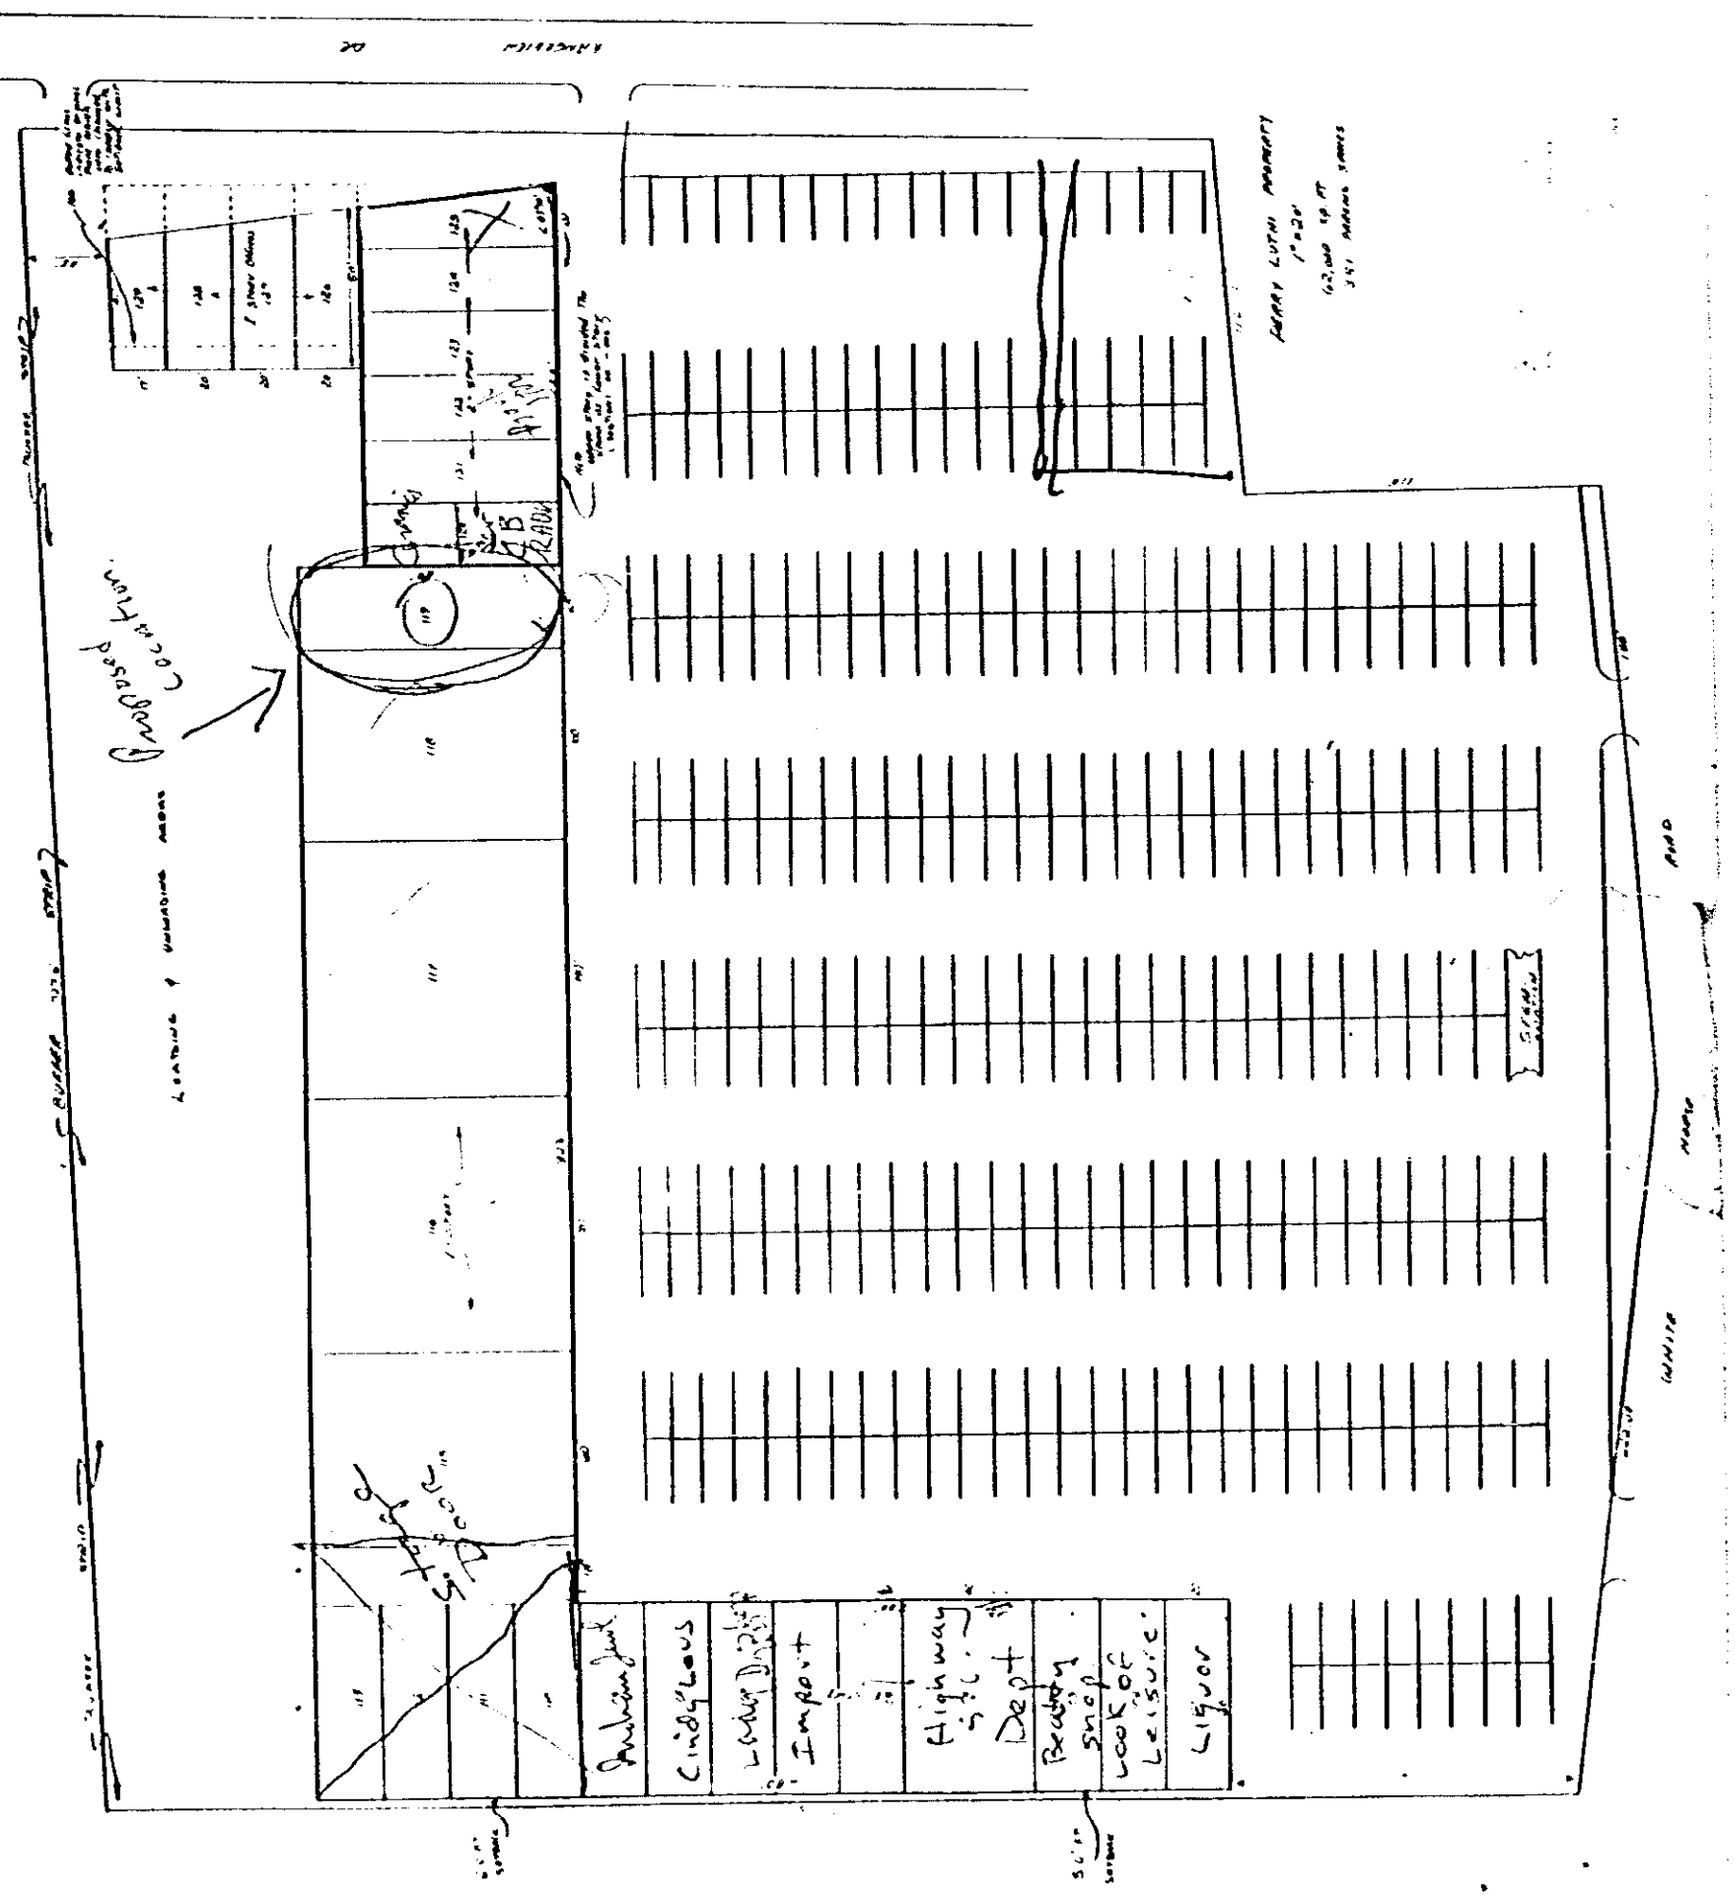

RECORDED DEC 23 '76 At 9:56 A.M. #16906

0490
4328 RV-2