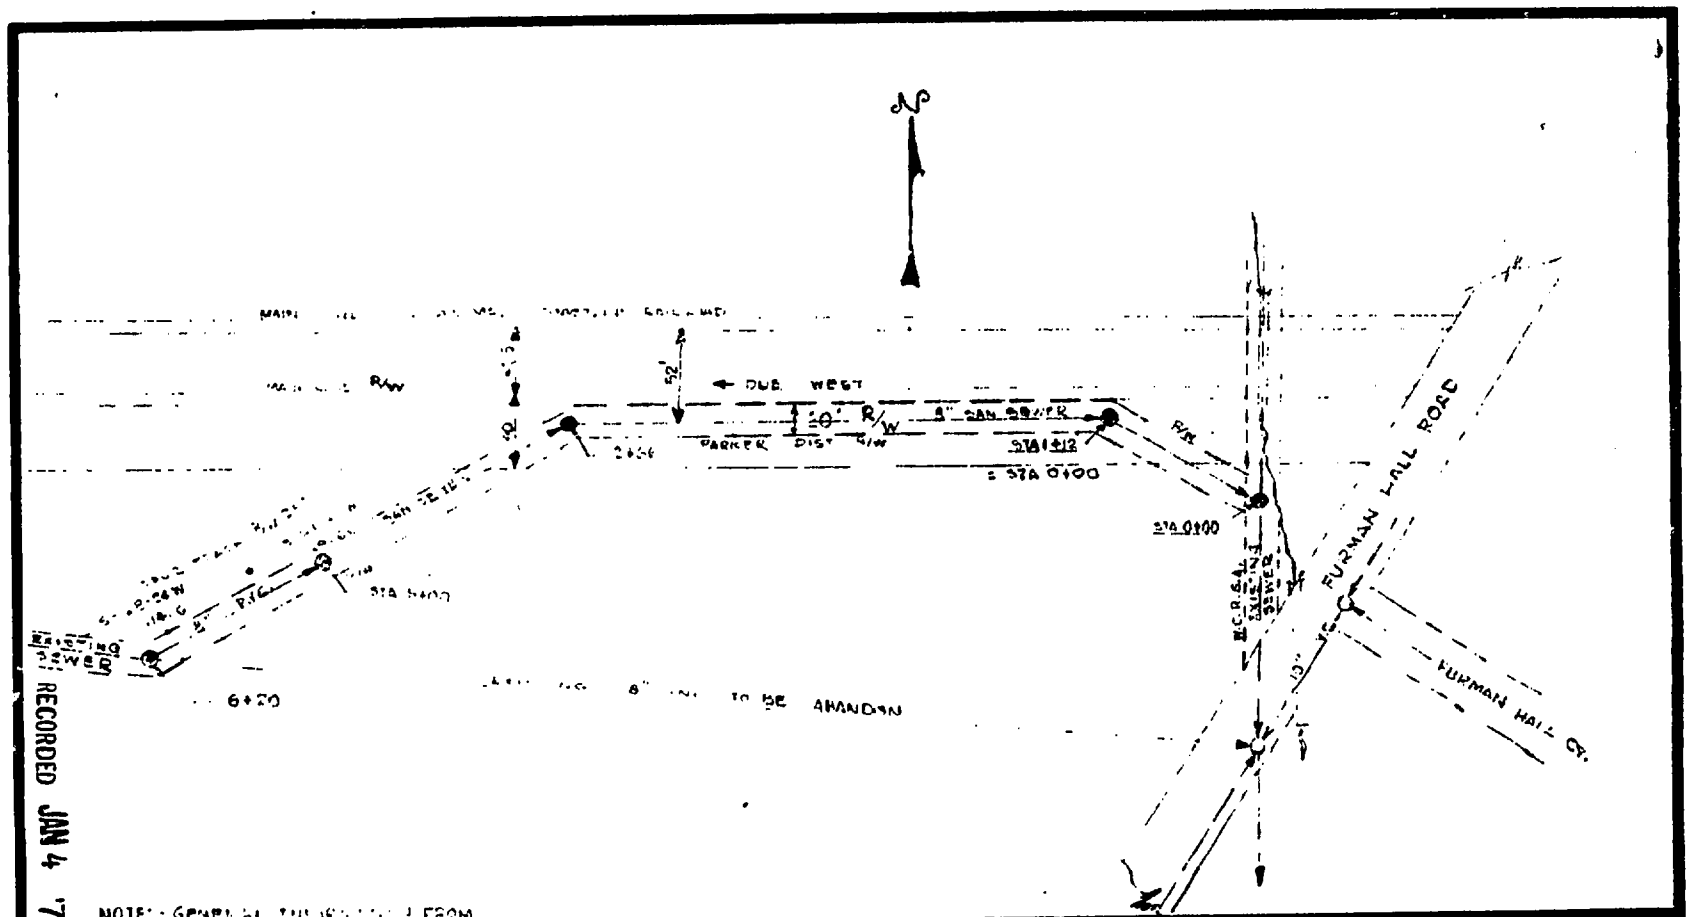

NOTE: - GENERAL THOROUGHFARE FROM PLAT OF BEATRICE FOODS CO. BY CALTON & HAYES CO.

PARKER SEWER & FIRE DISTRICT

GREENVILLE SOUTH CAROLINA

SCALE: 1" = 100	APPROVED BY:	DRAWN BY DENNIS
DATE: Nov. 10 · 76		REVISED ① - DEC - 29 - 76

RELOCATION OF 8" SAN SEWER LINE & RIGHT OF WAY CONTINENTAL SOUTHERN INDUSTRIES PROPERTY.

1- Change Station Nos - ADD MANHOLE

DRAWING NUMBER OM-76-4

RECORDED JAN 4 '77 At 2:37 P.M. 17755

VOL 1049 PAGE 95

4328 RV.2

0095