

Name and Post Office Address of Grantor _____ File No. _____

Toll Line _____ (Name)

or Exchange Line _____ (Exchange)

tributary to _____

The Property is bounded where the line enters and leaves this property by the property of:

_____ on the _____


and _____ on the _____

Authority _____ Classification _____

Area _____

Approved _____

Title _____

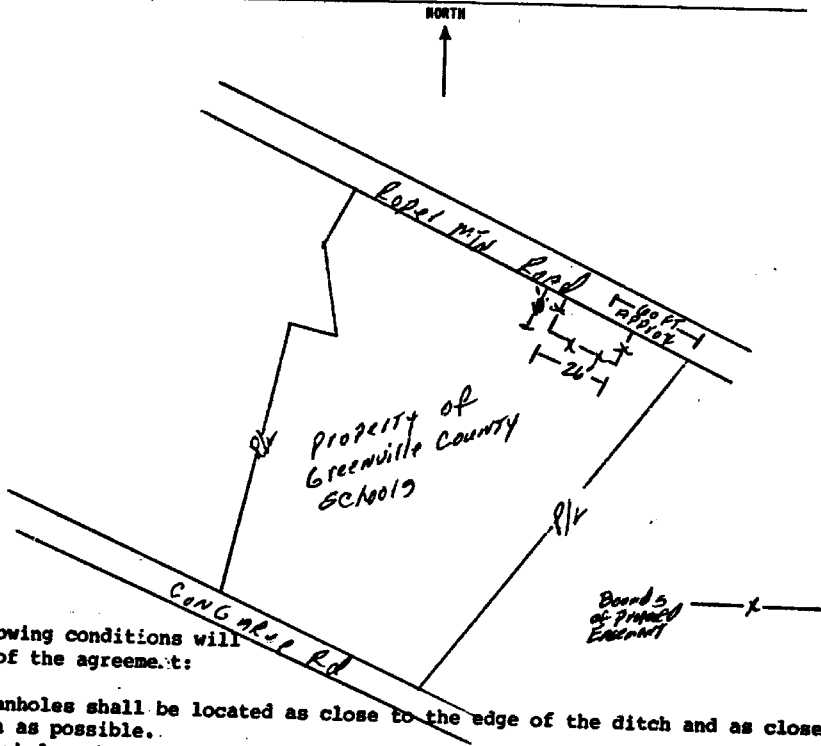

The following conditions will be part of the agreement:

1. The manholes shall be located as close to the edge of the ditch and as close to the church as possible.
2. The manholes shall be installed at a depth that will not interfere with the street level connections of the future driveways.
3. Remove only those trees as absolutely necessary. The location of the manholes should be shifted as necessary to avoid loss of any major trees.

RECORDED AUG 16 1977 At 2:08 P.M.


5212 *K*

Filed for record in the office of
 the R. M. C. for Greenville
 County, S. C. at 2:08 o'clock
 P. M. Aug. 16, 1977
 and recorded in Deed Book
 1062 at page 678

R. M. C. for G. Co. S. C.

AUG 16 1977 *Dr*
Mail Box Envelope

5212

 

4328 IN-2