


N
MAGNETIC

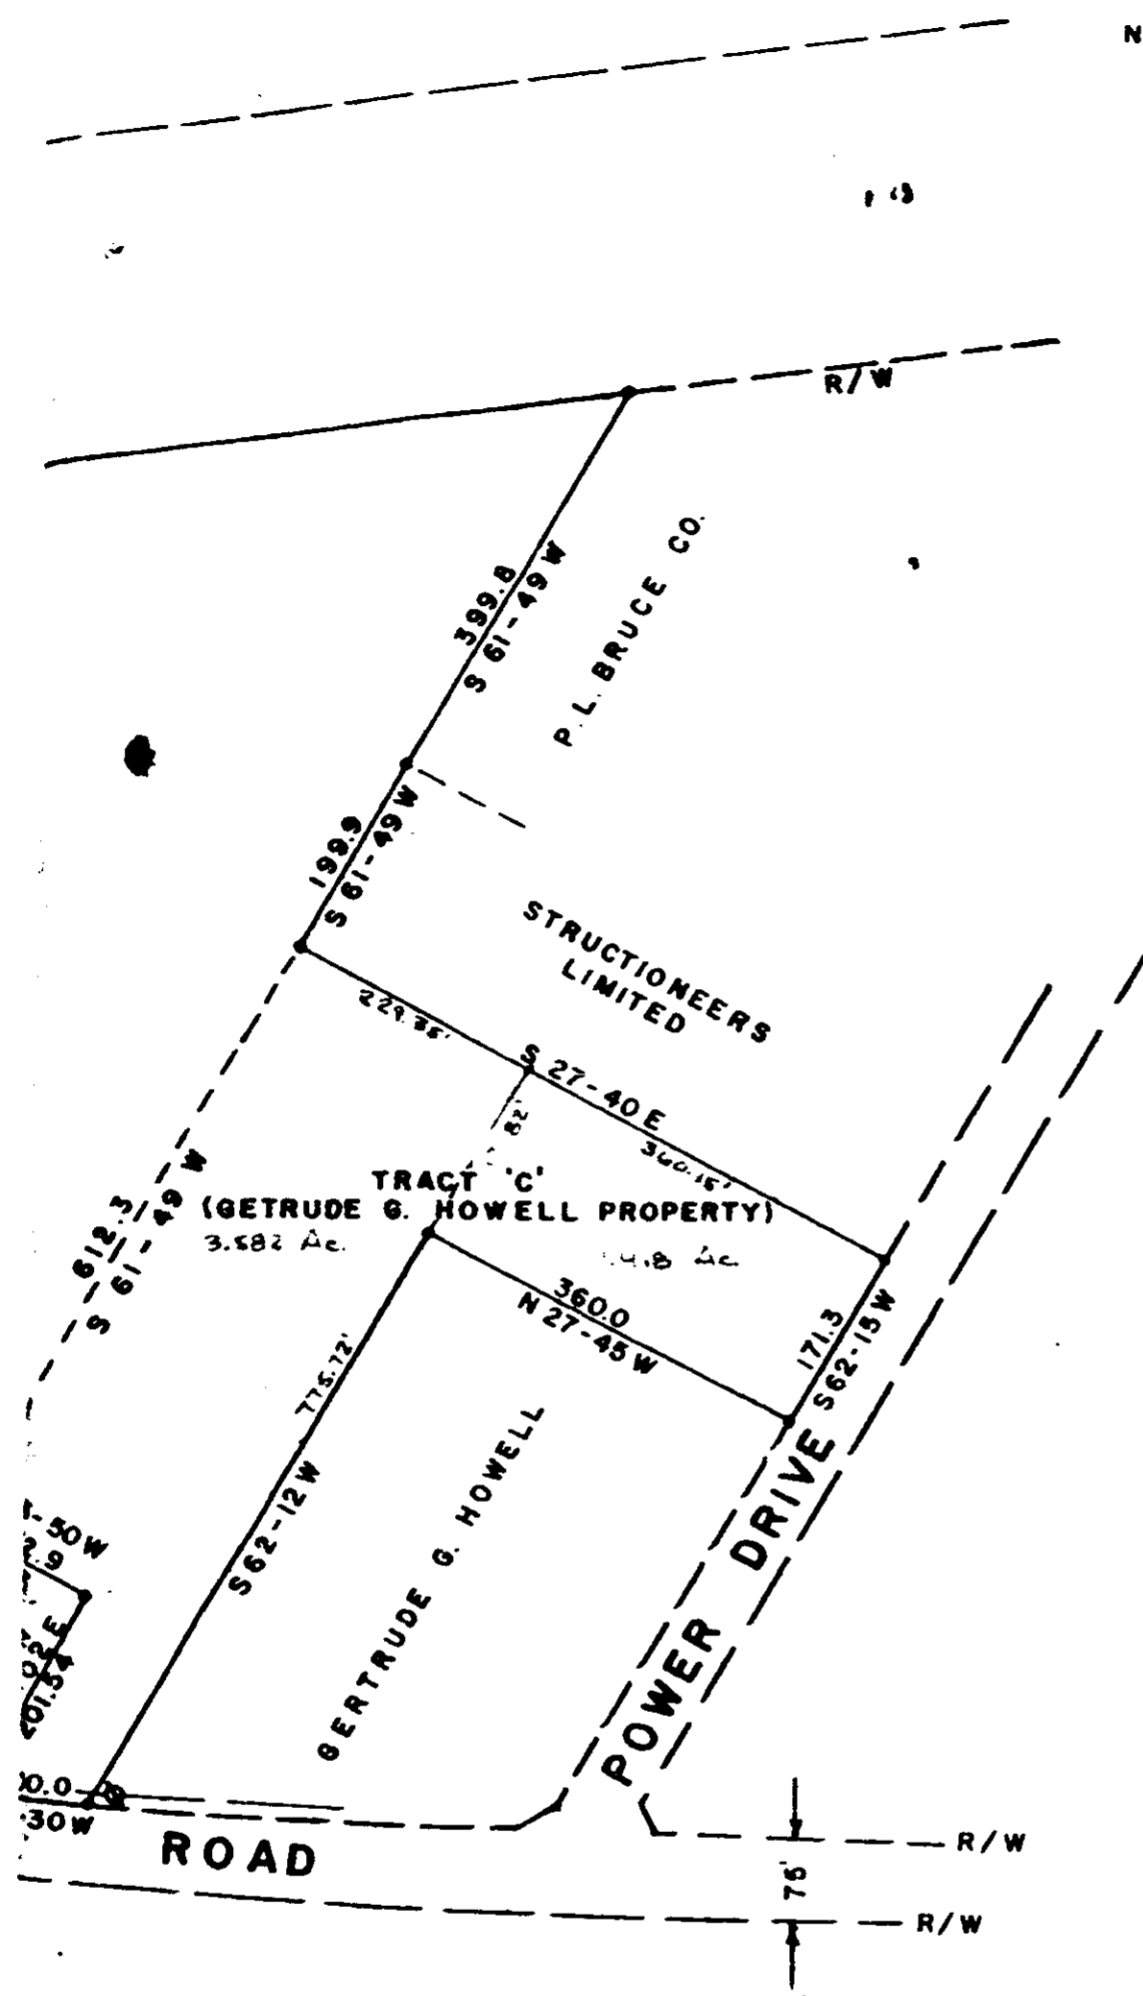

0849

CORPORATION

C.

DATE: 12-18-72
REV. 2-10-76

EXHIBIT "I"

[4328 RV.2]