

Name and Post Office Address of Applicant
Melvin Younts
512 E. North Street
Greenville, South Carolina 29601


Toll Line or Exchange Line tributary to _____ (No. or Exchange)

The Property is bounded where the line enters and leaves this property by the property of:
Greenacre Road on the East
 and _____ on the _____

Authority 743-2081 Classification 945-C
 Area Greenville, South Carolina

Approved _____
 Title District Engineer

BURIED C.A. CENTER
 IS 20' SOUTH OF
 (REAR) HAVERTY'S BLDG

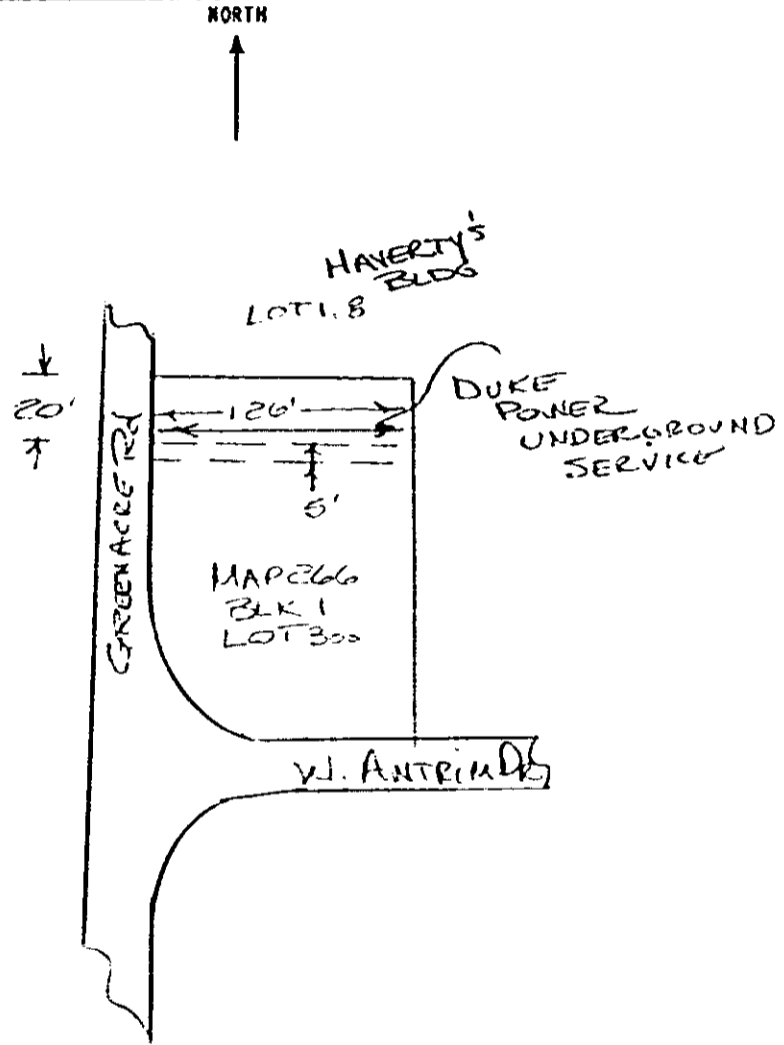

RECORDED OCT 14 1977 At 10:34 A.M. 11781

Filed for record in the office of
 the R. M. C. for Greenville
 county, S. C. at 10:34 o'clock
 A. M. Oct. 14, 1977
 and recorded in Deed Book
 1066 at page 820
 R. M. C. for G. Co. S. C.

11781
 7X COI 11/15/77

Permittee Fred East District
 Sullivan Road

9/13 document