


BLOCK BOOK NO.	NAME	LENGTH OF SEWER (FEET)	LENGTH OF SIDEWALK (FEET)	AMOUNT
T 31-1-1	UNITED DEVELOPMENT SERVICE INC.	103'	110'	0
T 35-1-13	ACADEMY RENTAL CO.	5'	25'	0

VOL 1067 PAGE 775

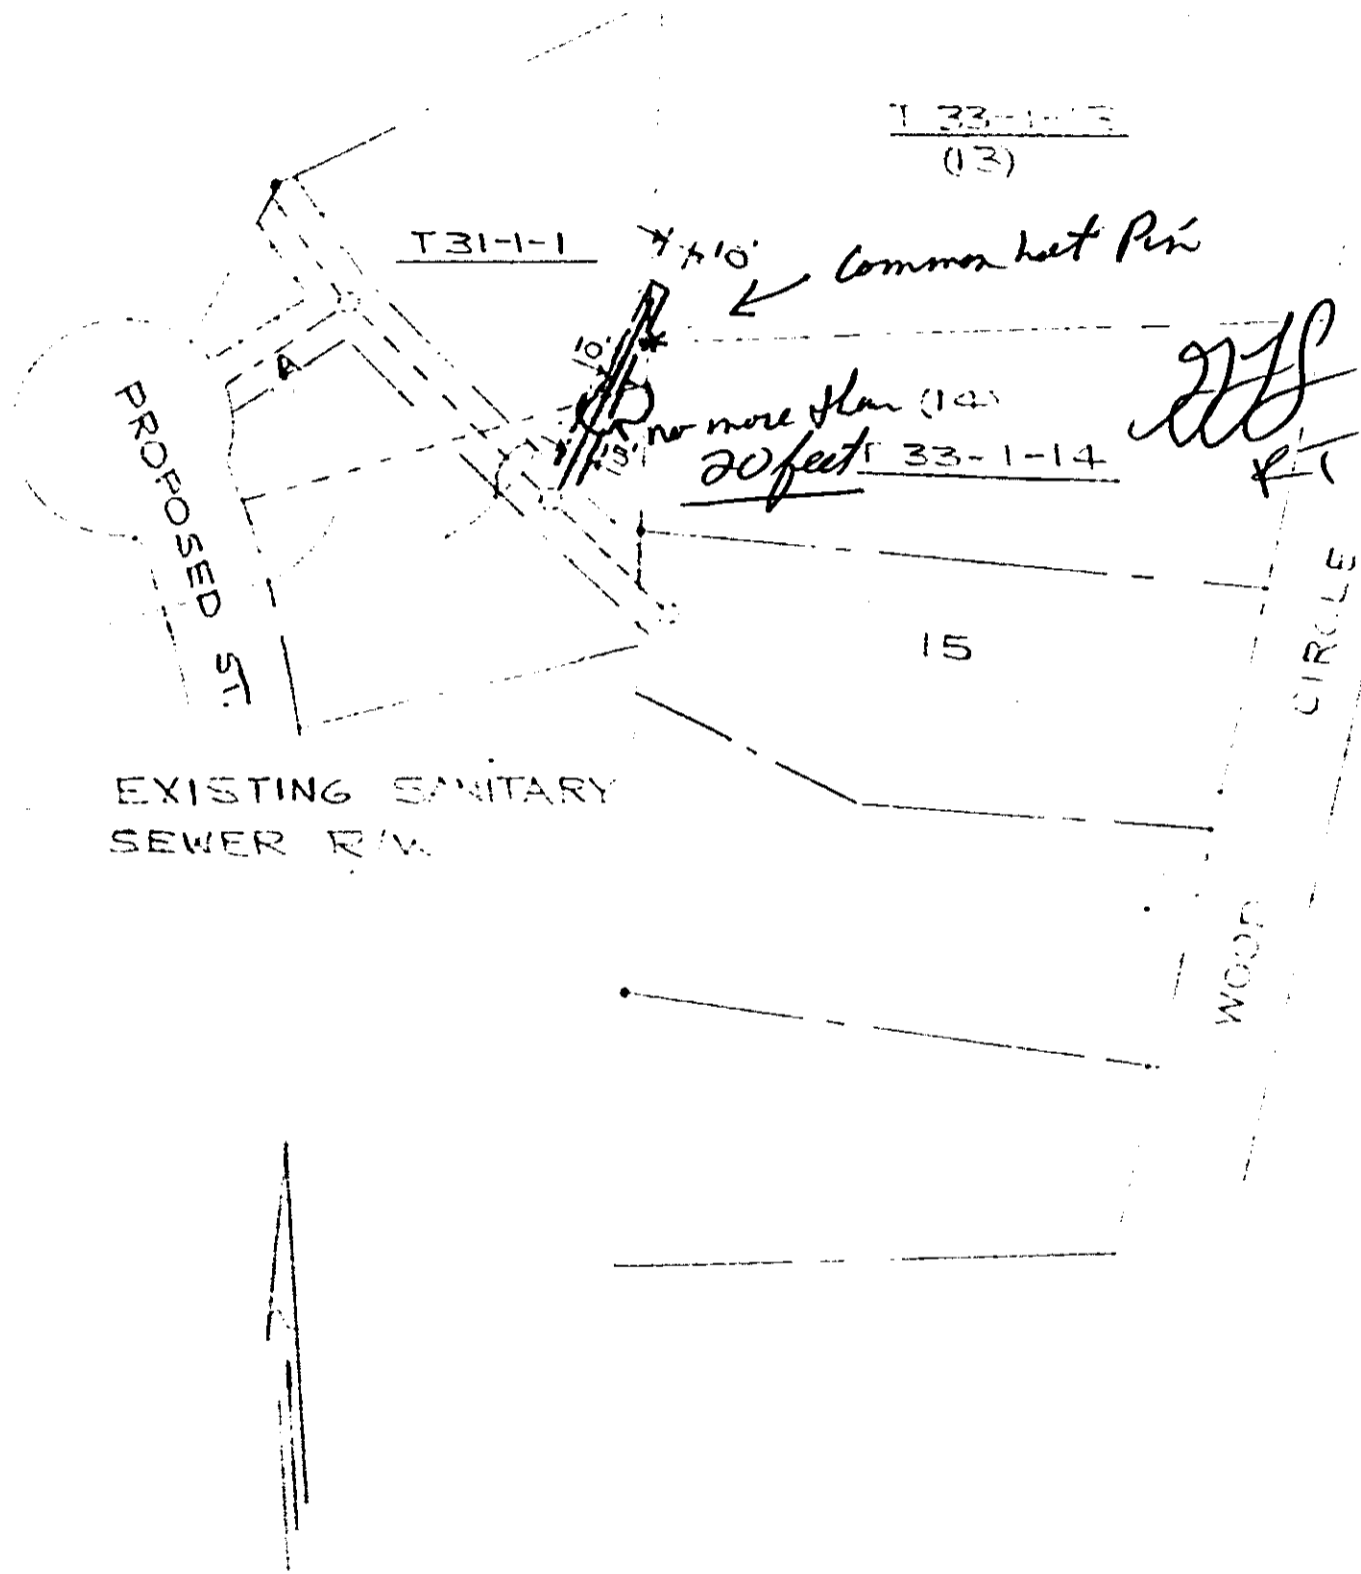

REVISED 12-1-76

11 1-11-77

SKETCH OF

PROPOSED SANITARY SEWER LINE TO SERVE

LOT 13

SCALE 1" = 100'

13767

RECORDED NOV 2 1977 At 12:52 P.M.

PIEDMONT ENGINEERS ARCHITECTS & PLANNERS

9/21/76

5
0.77

4328 RV-21