


1070

Mr. Robinson
 P. O. Box 969
 Greenville, S. C. 29651

 Hale Drive east side
 P-43130 945C
 Greenville, South Carolina
 District Engineer

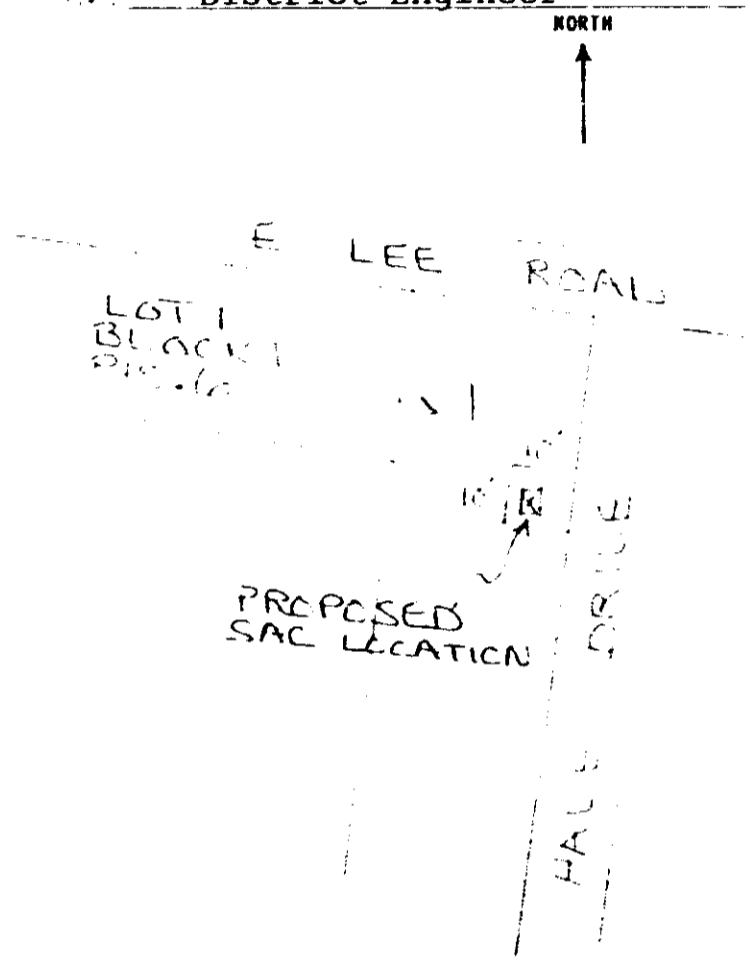

RECORDED DEC 22 1977 At 3:44 P.M. 1070

Filed for record in the office of
 the R. M. C. for Greenville
 county, S. C. at 3:44 P.M. of Book
 P. M. Dec. 22, 1977
 and recorded in Deed Book
 1070 at page 703
 R. M. C. for G. Co. S. C.

Handwritten signature

DEC 22 1977
 X X
Handwritten notes and initials

4328 RV-2

07020