









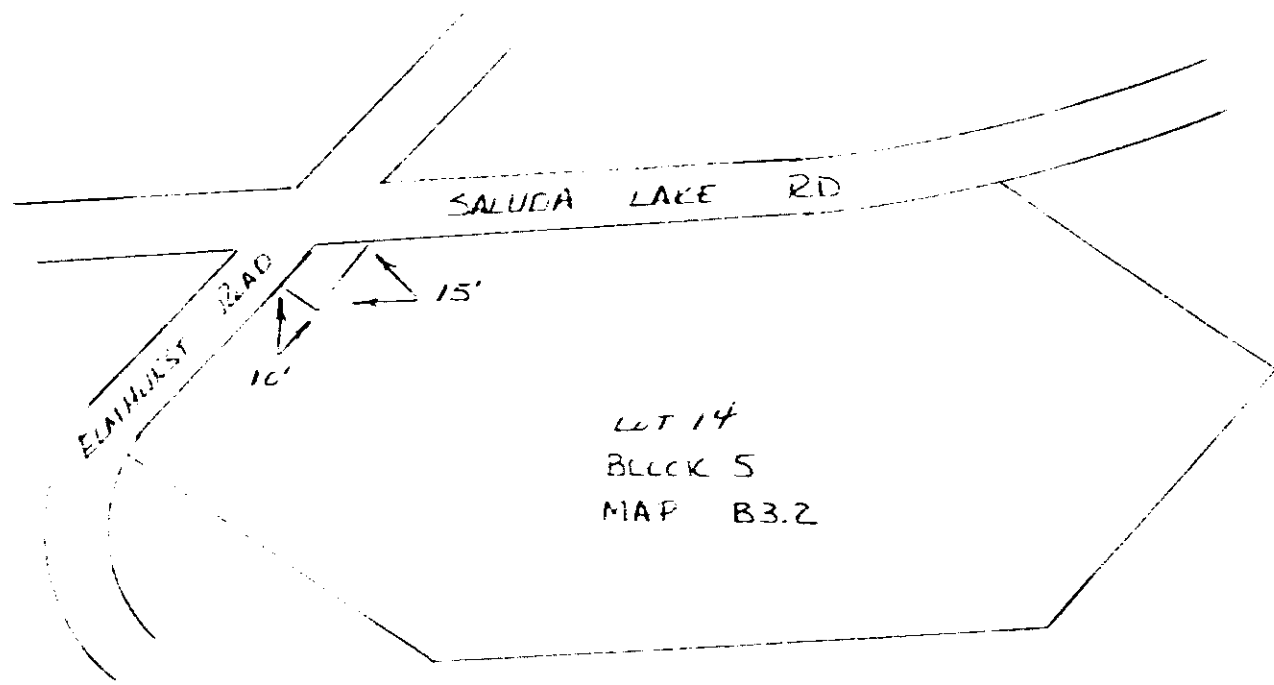

RECORDED DEC 22 1977 At 3:44 P.M. 19050

Filed for record in the
 the R. M. C. for Greenville
 county, S. C. at 3:44
 P. M. Dec. 22, 19
 and recorded in Deed Book
 1070 at page

R. M. C. for G. Co. S. C.

made
 see - 10/1/77

4328 RV.2

0706