


DETAILS OF SUBSTATION LOT
SCALE 1"=30'

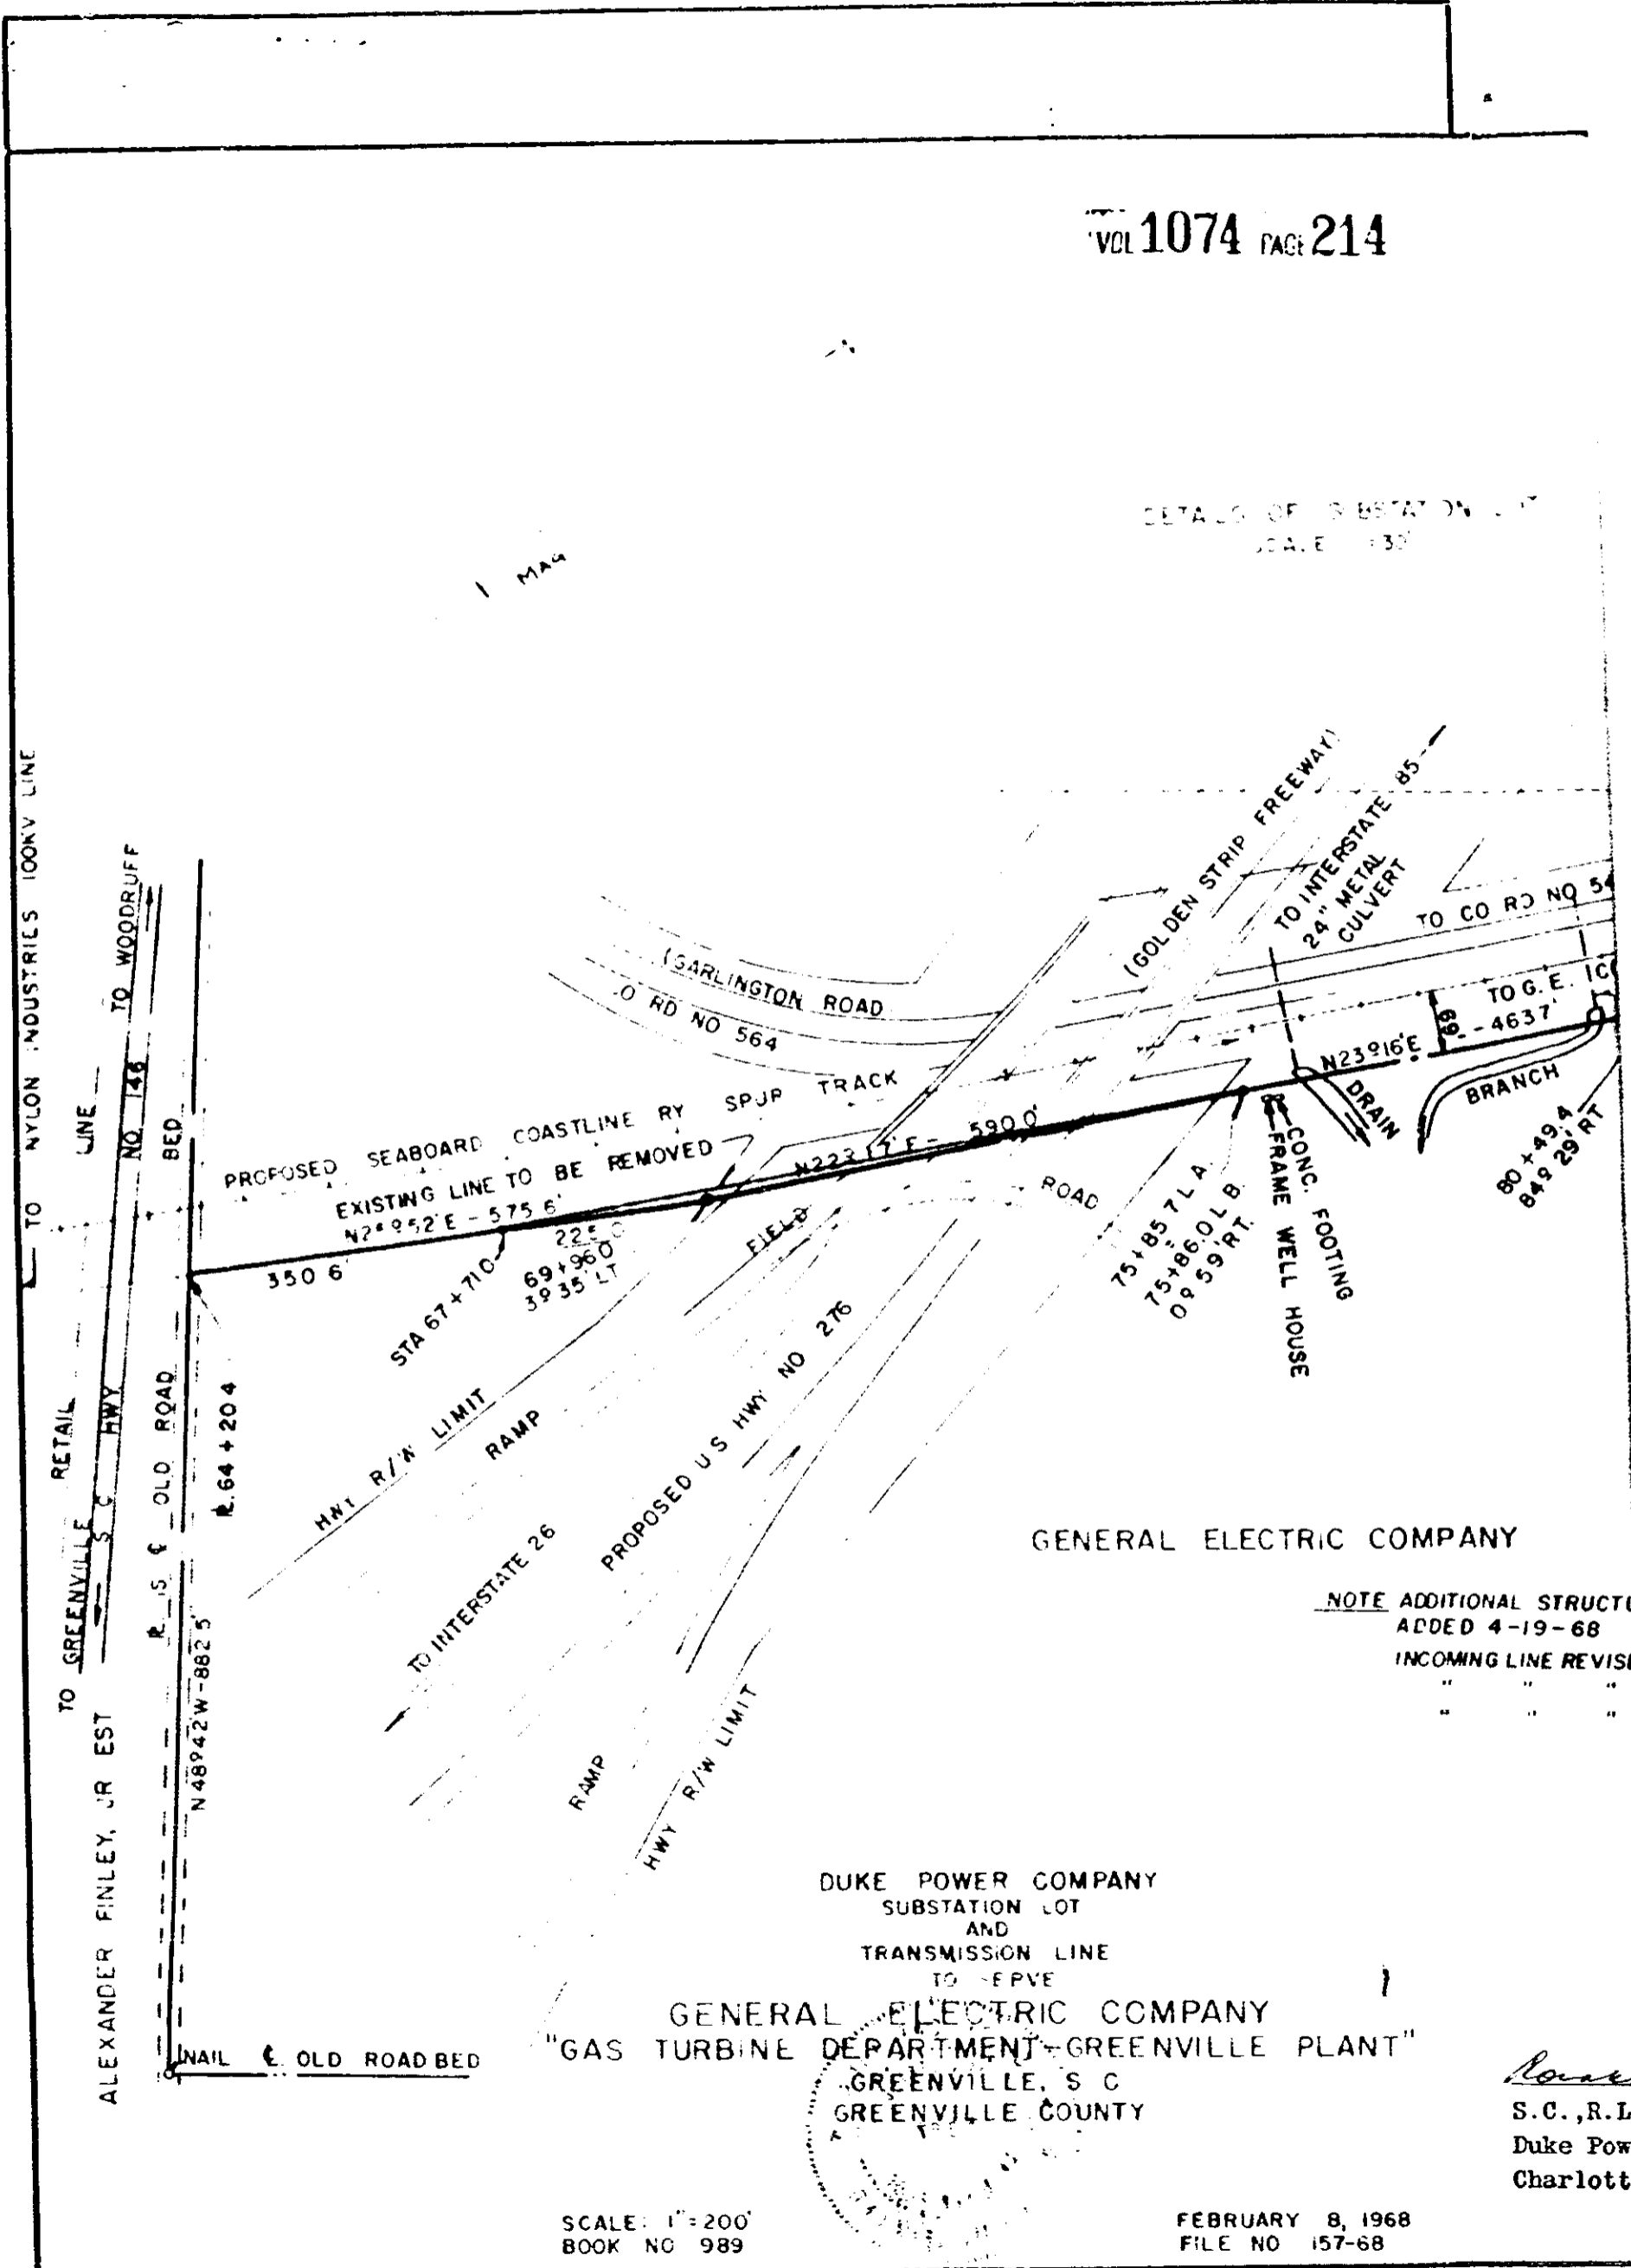

GENERAL ELECTRIC COMPANY

NOTE ADDITIONAL STRUCTURE
 ADDED 4-19-68
 INCOMING LINE REVISED
 " " "
 " " "

DUKE POWER COMPANY
 SUBSTATION LOT
 AND
 TRANSMISSION LINE
 TO SERVICE

GENERAL ELECTRIC COMPANY
 "GAS TURBINE DEPARTMENT - GREENVILLE PLANT"
 GREENVILLE, S C
 GREENVILLE COUNTY

Ronald
 S.C., R.L.S.
 Duke Power
 Charlotte

SCALE: 1"=200'
 BOOK NO 989

FEBRUARY 8, 1968
 FILE NO 157-68

lbm

4328 RV-2

0214