

Name and Post Office Address of Grantor Horace L. Taylor  
Dublin Road  
Greenville, South Carolina


Toll Line \_\_\_\_\_ (State)  
 or Exchange line Greenville \_\_\_\_\_ (Exchange)  
 tributary to \_\_\_\_\_

The Property is bounded where the line enters and leave this property by the property of:  
K. R. Summers on the North east  
Highway 548 on the South

Authority P-43403 Classification 94-C  
 Area Greenville, South Carolina

Approved \_\_\_\_\_  
 Title District Engineer

$1.00 \times 835' = 835$   
 $50.00 \times 1 = 50$   
 $\hline 885$

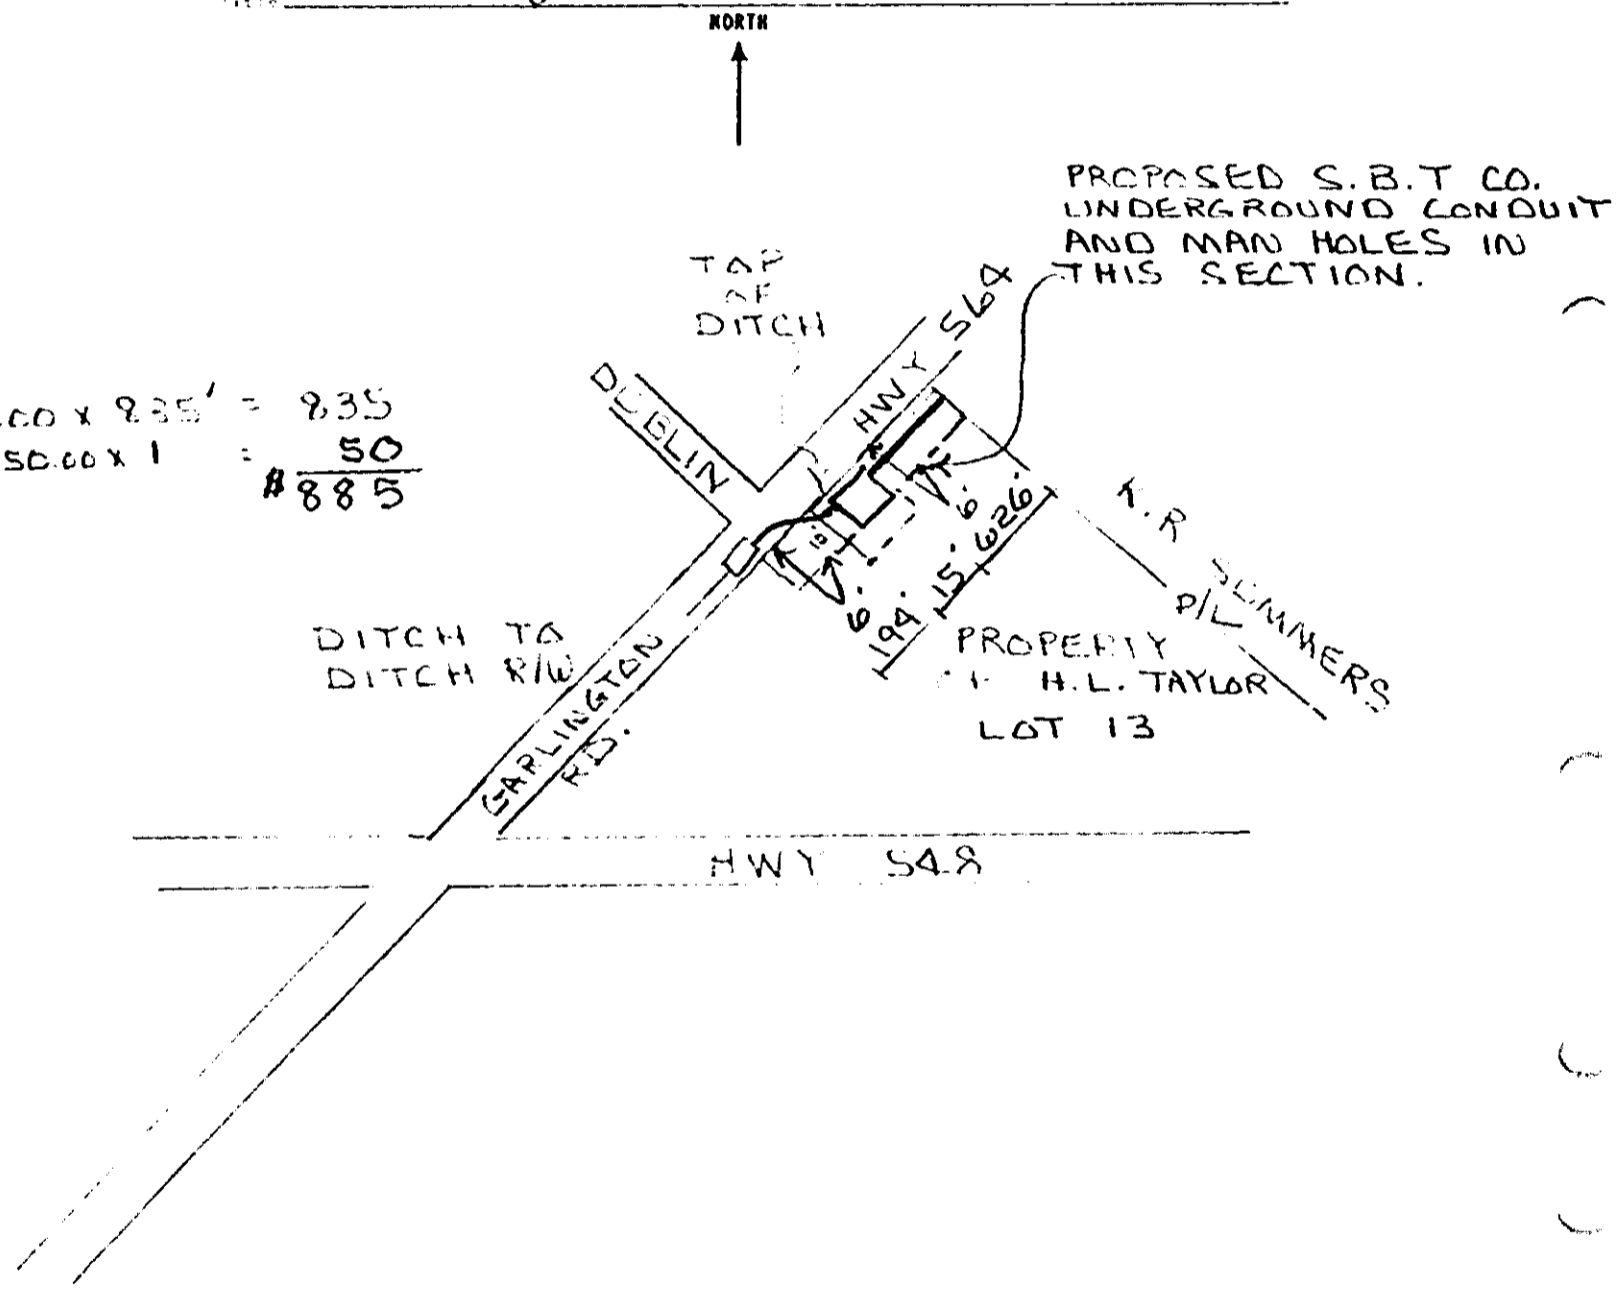

RECORDED JUN 12 1978 at 11:26 A.M.

37145

JUN 12 1978

4 X 37145

Filed for record in the office of  
 the R. M. C. for Greenville  
 county, S. C. at 11:26'clock  
 A. M. June 12, 1978  
 and recorded in Deed Book  
 1080 at page 945

R. M. C. for G. Co. S. C.

4328 RV-2

5766