


VEL 1082 PAGE 377

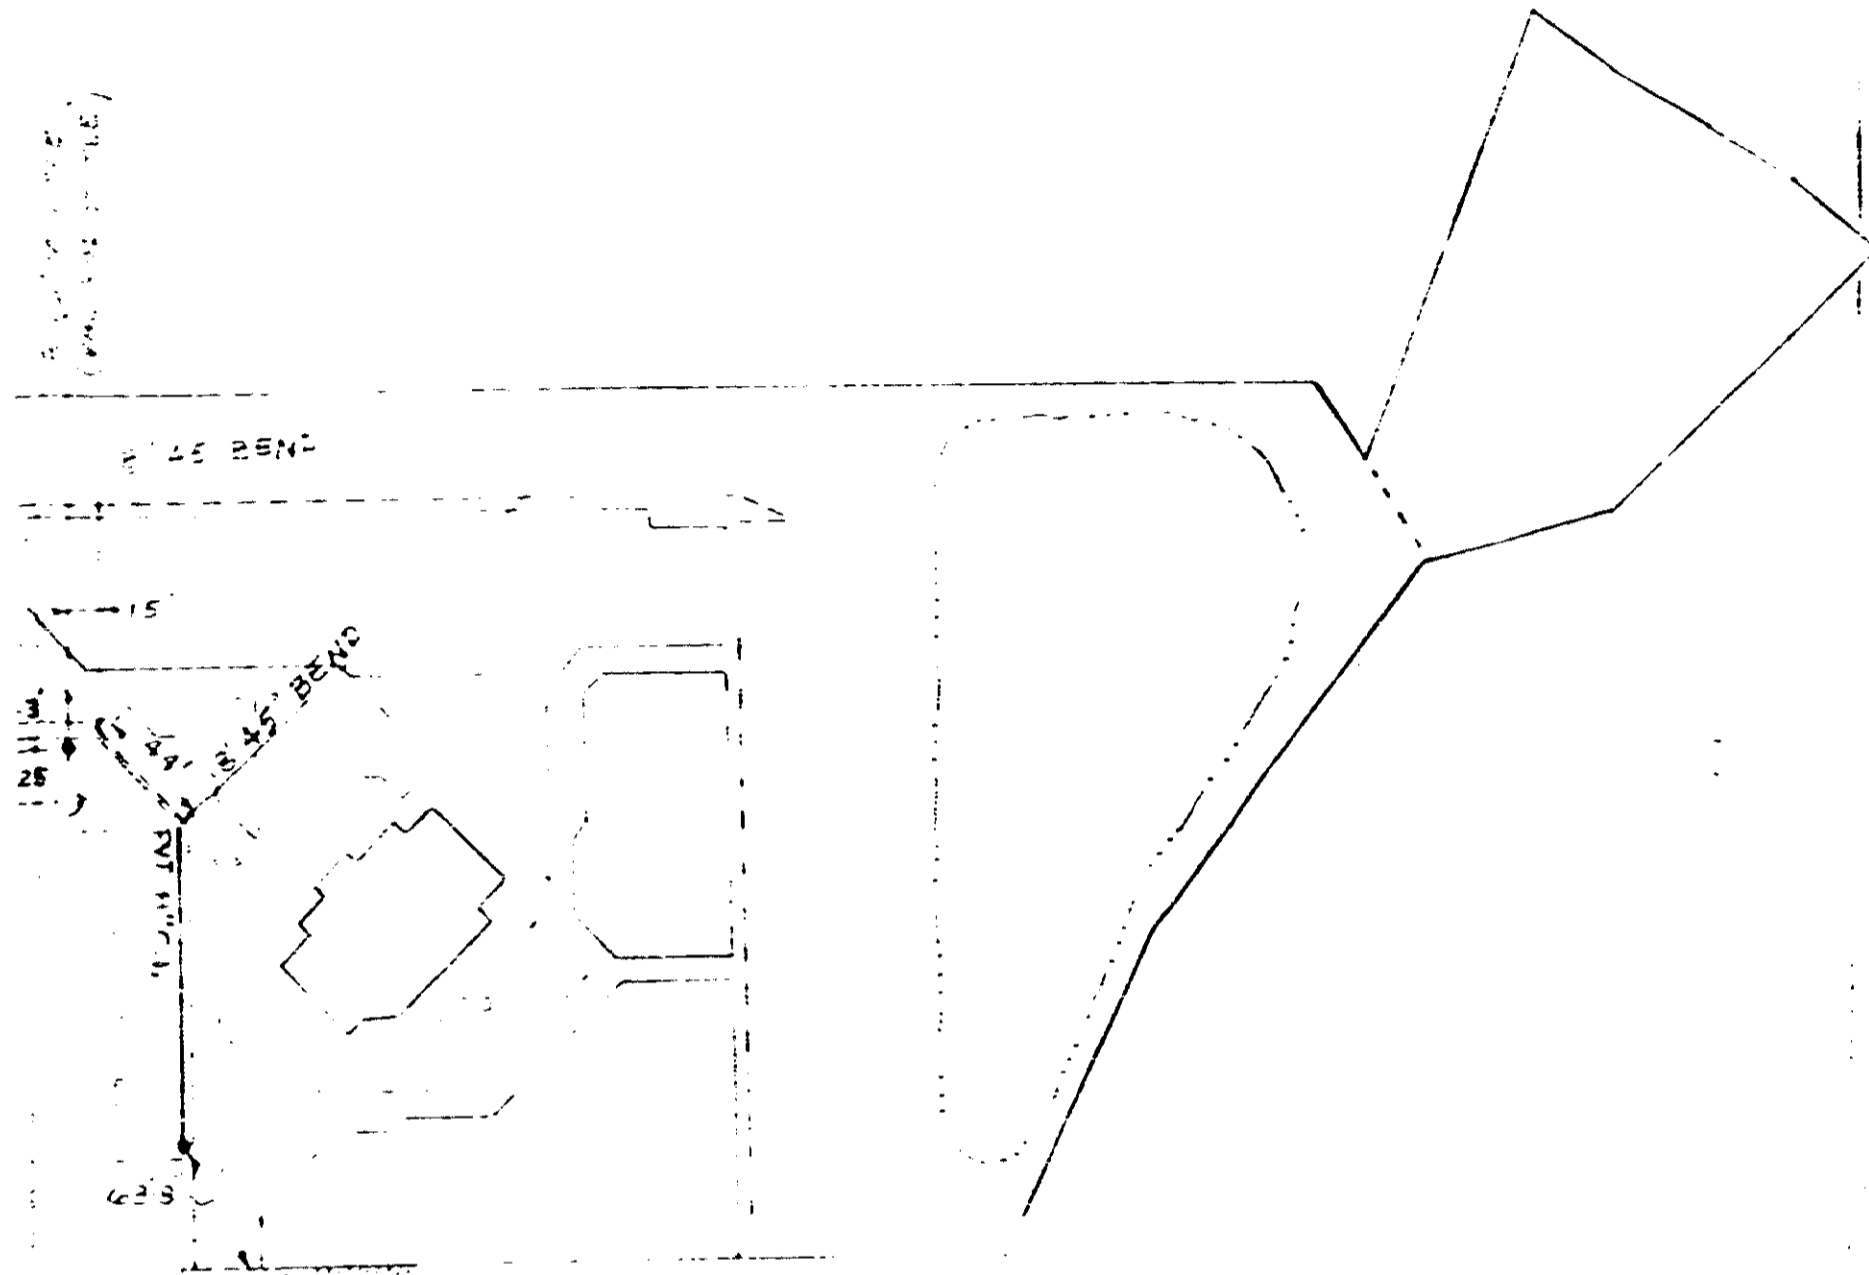

NOTE: ALL 6" & 8" VALVES TO OPEN RIGHT  
2" VALVE TO OPEN LEFT  
FIRE HYDRANT TO BE 3-WAY & OPEN RIGHT

VAUGHN'S AT EAST - NORTH

DEC, 1977 SCALE 1" = 100'

Trinity S. A. L. Inc. ✓  
 City Engineer of Public Works  
 of the City of Greenville, S. C.  
 April 18, 1978  
 PT. of 541 3-1-3  
 EASEMENT

177

RECORDED JUL 3 1978 at 11:15 A.M.

937A

4328 RV.2