


Name and Post Office Address of Grantor H. H. Forrester & Mary W. Forrester
Route 6,
Greenville, South Carolina

Toll Line or Exchange Line tributary to _____ (Name)
 _____ (Exchange)

The Property is bounded where the line enters and leaves this property by the property of:
Eastern Business Forms on the North
Virginia M. Forrester on the South

Authority 843-0040 Classification 945C
 Area South Carolina

Approved _____
 Title District Manager - Engineering

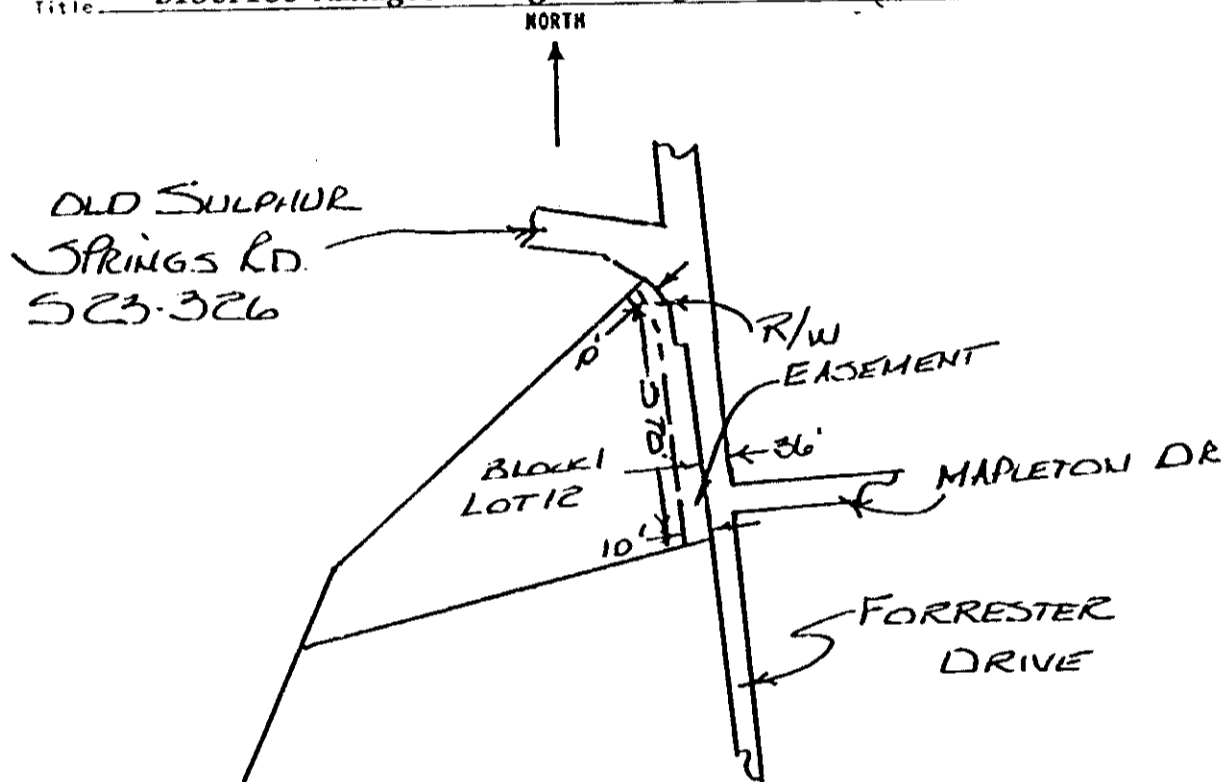

RECORDED DEC 13 1978 at 10:36 A.M.

17915

17915X*

17915X*

Filed for record in the office of
 the R. M. C. for Greenville
 county, S. C. at 10:36'clock
 on 7 M Dec. 13, 19 78
 and recorded in Deed Book
1093 at page 708
 R. M. C. for G. Co. S. C.

Handwritten notes:
 H. H. Forrester
 Mary W. " "
 S. B. ...

4328 RV-2

0709