


Exhibit A

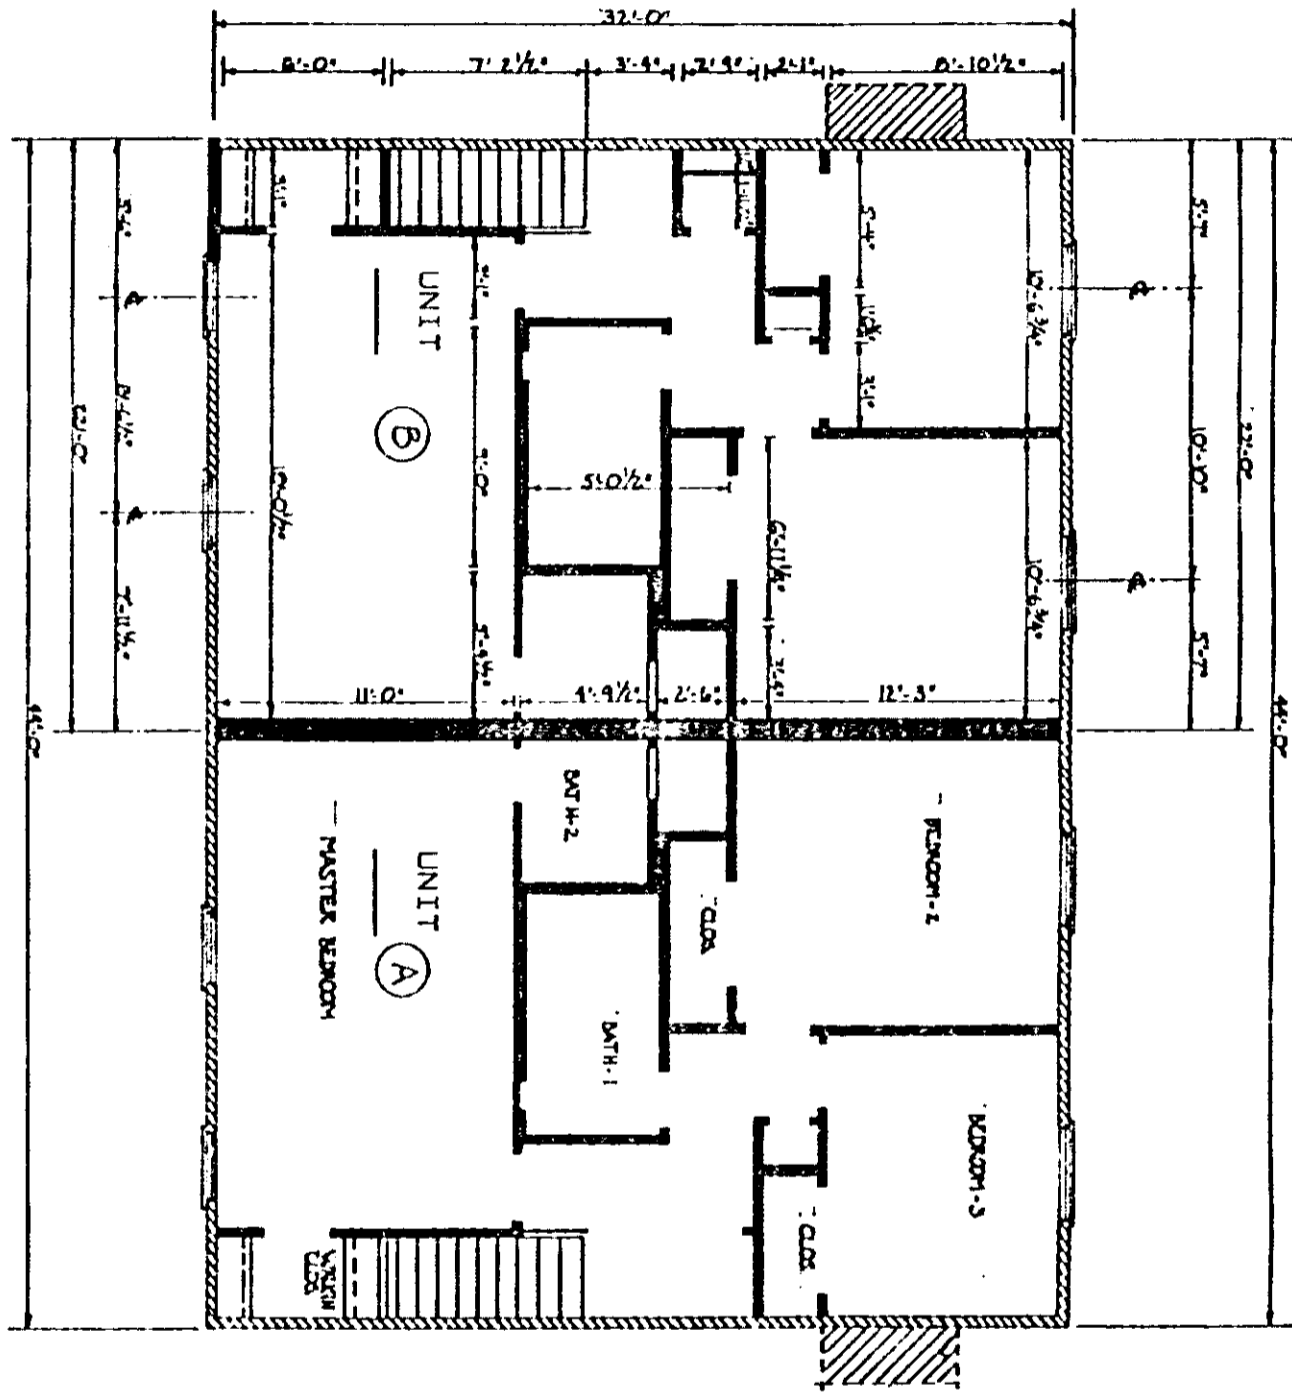


SECOND FLOOR PLAN

CERTIFICATE

I, Wade H. Barber, do hereby certify that these plans fully depict within reasonable construction tolerances the layout, location, letter identification and dimensions of the buildings and dwellings contained therein.

*Wade H. Barber*

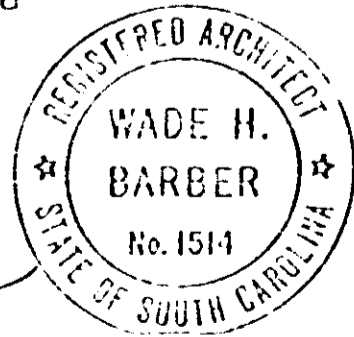

0550

4328 RV-2