


Exhibit A

VOL 1034 PAGE 353

VOL 1035 PAGE 422

0420

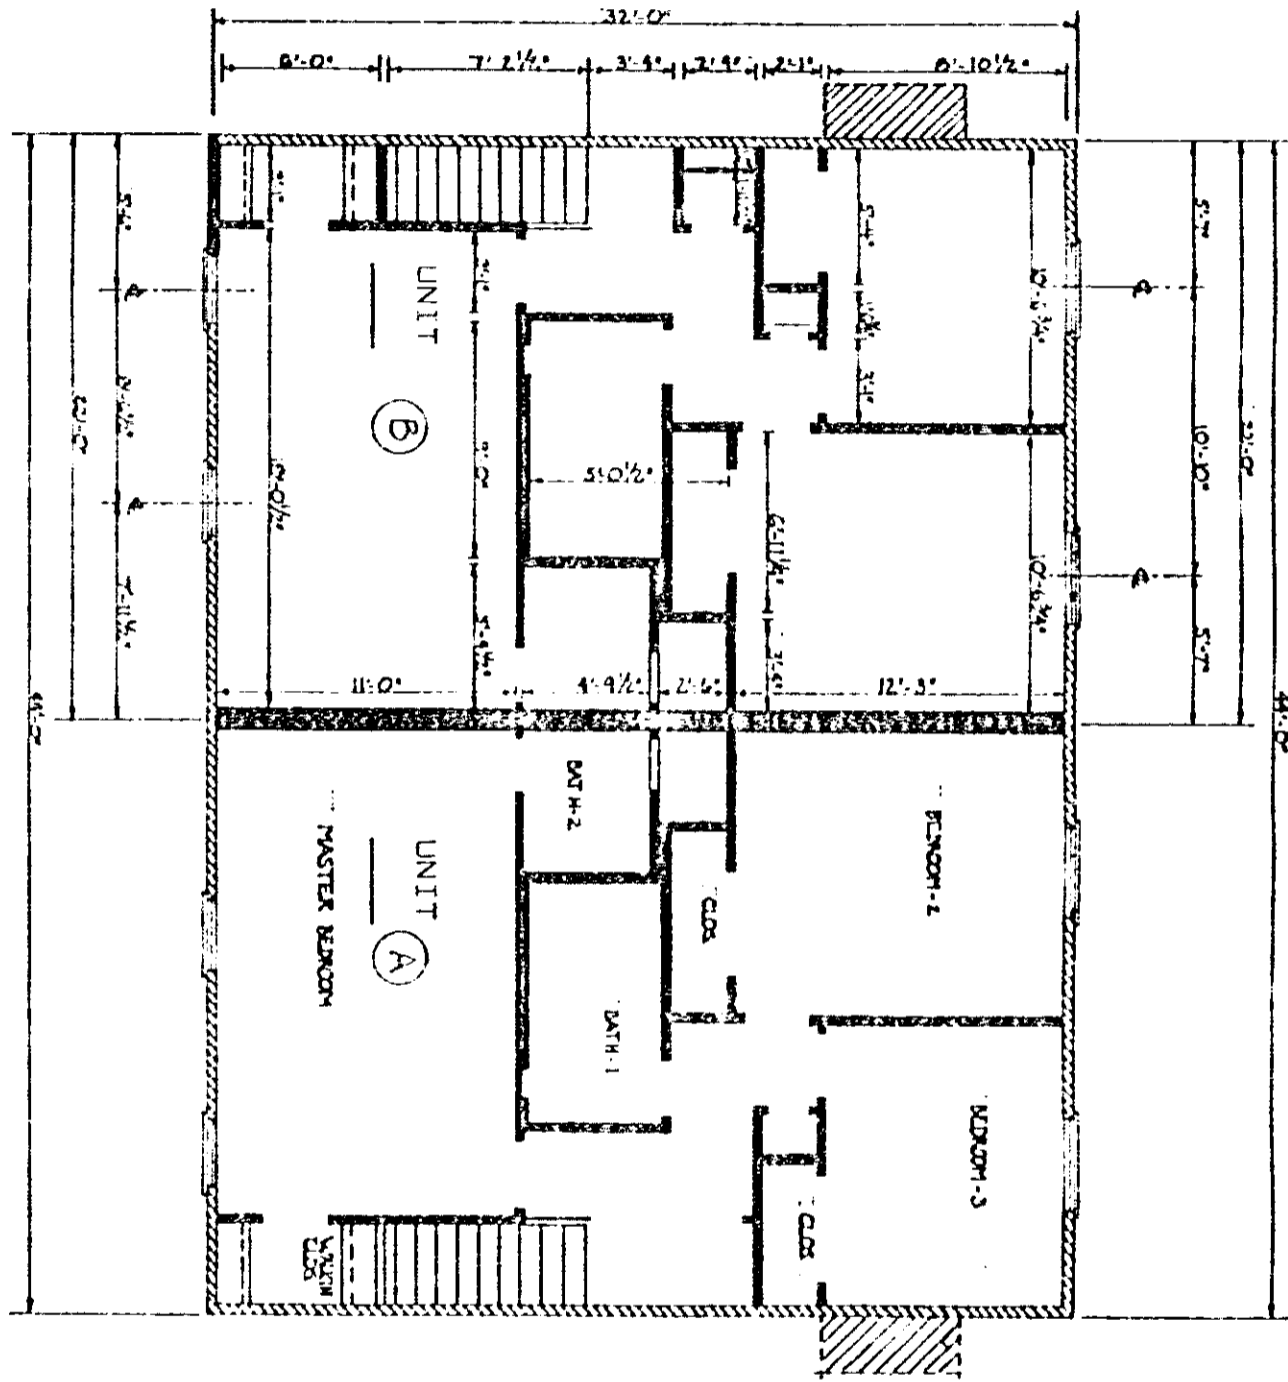


SECOND FLOOR PLAN

CERTIFICATE

I, Wade H. Barber, do hereby certify that these plans fully depict within reasonable construction tolerances the layout, location, letter identification and dimensions of the buildings and dwellings contained therein.

Wade H. Barber

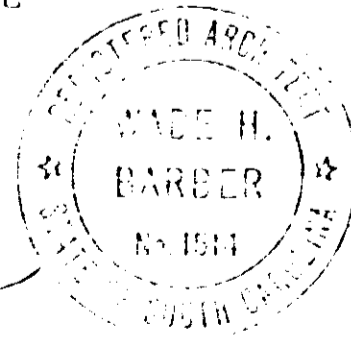

4328 RV-2